

SURVEY & REMONUMENTATION

MAR 9 8 1989

LAND CORNER RECORDATION CERTIFICATE  
Filing Requirement of Act 74, Mich. P.A. 1970  
KENT COUNTY REMONUMENTATION

For corners in

SECTION

Kent (County)	Located in:	Vergennes Township	Corner Code #
1. Public Land Survey	T <u>7N</u>	R <u>9W</u>	<u>E-10</u>
	T _____	R _____	_____
	T _____	R _____	_____
	T _____	R _____	_____
2. Property Controlling in Section	S _____	T _____	R _____
	S _____	T _____	R _____
3. Miscellaneous Property in Sec.	S _____	T _____	R _____
	S _____	T _____	R _____


STATE OF MICHIGAN  
COUNTY OF KENT  
RECEIVED FOR RECORD  
39 OCT 23 AM 9:57  
REG. OF DEEDS  
*Rob Jonker*

10763

Register of Deeds Stamp & File Number

4. Lot No. \_\_\_\_\_, Recorded Plat \_\_\_\_\_  
5. Private Claims \_\_\_\_\_

I, Randy Kolehouse, in a field survey on January 7 19 98, do hereby certify that under requirements of P.A. 74 Michigan P.A. of 1970, the corner points mentioned in lines 1 and 2 above were in conformance with regulations and rules therefore as required in the current manual of survey instructions of the United States Department of the interior, Bureau of Land Management or by a decree of a Court of Law and/or that the corner points mentioned in lines 3, 4 and 5 above were in conformance with the rules of the Michigan Board of Land Surveyors or by a Decree of a Court of Law; established, re-established, monumented, re-monumented, recovered, found as expressed below:

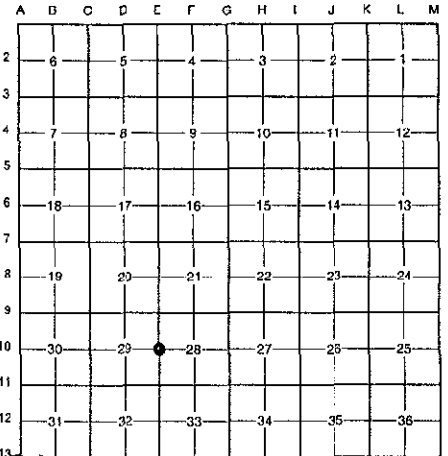

NOTE: Not more than 4 corners, all in the same town and range, may be recorded on this certificate.

A. Description of original monument and accessories and/or subsequent restoration:

E-10 1838	G.L.O. Notes	N. Brookfield	Set Post
N/A	Witness Map	K.C. Surveyor	Leaded Stone
1978	L.C.R.C. #1209	Nederveld & Jonker	Angle Iron
1981	L.C.R.C. #1934	Jonker Land Survey	Fnd. Angle Iron / Set K.C. Monument
1991	L.C.R.C. #5845	Exxel Engineering	K.C. Monument

P.A. 345 1990 KENT COUNTY

PEER APPROVED 2/19/98

CHAIRMAN Randy Kolehouse

This corner was originally approved by the Kent County Remonumentation Peer Group and monumented by Rob Jonker on 8/4/81 and was recorded per L.C.R.C. #1934.

B. Description of corner evidence found and/or method applied in restoring or reestablishing corner:

E-10 Found a Standard Kent County Monument 7' East of the C/L of Cumberland Avenue (gravel) running North and South per L.C.R.C.'s #1934 and #5845 as set by Rob Jonker in place of an angle iron he found which checked L.C.R.C. #1209.

L.C.R.C. #1934

L.C.R.C. #5845

Remon. tag on E side 14" Oak N32°W 44.14'  
Iron at fe. corner N88°W m/l 33.00'  
Iron S88°E m/l 33.00'


Nail & remon tag in E side 18" Oak N 31°W 44.14' (m. 44.20')  
Nail & remon tag in SW side 24" Oak S 44°E 20.50' (m. 20.50')  
Nail & remon tag in N side 18" Oak N 84°W 38.85' (m. 38.87')  
Nail & remon tag in SE side 10" Pine S 59°W 58.52' (m. 58.54')  
Nail & remon tag in W side twin 8" Oak S 03°E 58.14' (m. 58.16')

The selected location is accepted by me and is generally accepted by professional surveyors as the best available evidence of the position of the original corner.

C. Description of monument for corner and accessories established to perpetuate locating the position of the corner:

E-10 Standard Kent County Monument

Nail & K.C. remon. tag on E side 18" Oak N 31° W 44.20'  
Nail & K.C. remon. tag on SW side 24" Oak S 44° E 20.50'  
Nail & K.C. remon. tag on N side 18" Oak N 84° W 38.87'  
Nail & K.C. remon. tag on SE side 10" Pine (half tree 7' high) S 03° E 58.54'  
Nail & K.C. remon. tag on W side 8" Twin Oak S 03° E 58.16'  
C/L gravel road running N-S, West 7.0'

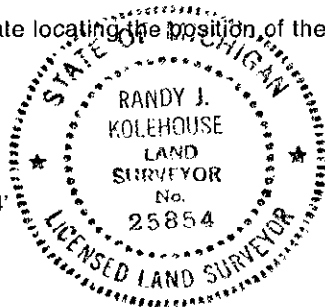

Signed by Randy J. Kolehouse  
EARTH TECH

Date 9-1-98

Surveyor's Michigan License No. 25854