SURVEY & REMONUMENTATION

MAR 08 1999

$7.00
$2.00

SECTION

LAND CORNER RECORDATION CERTIFICATE
Filing Requirement of Act 74, Mich. P.A. 1970
KENT COUNTY REMONUMENTATION

STATE OF MICHIGAN
COUNTY OF KENT
RECEIVED FOR RECORD
98 OCT 23 AM 9:57
REG. OF DEEDS

10764
Register of Deeds Stamp & File Number

For corners in Kent (County) Located in: Vergennes Township Corner Code #

1. Public Land Survey		T 7N	R 9W	E-11
		T	R	
		T	R	
		T	R	
2. Property Controlling	S	T	R	
in Section	S	T	R	
3. Miscellaneous	S	T	R	
Property in Sec.	S	T	R	

4. Lot No._____, Recorded Plat _____
5. Private Claims _____

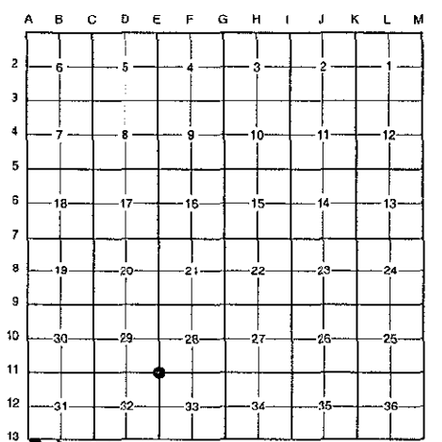

I, Randy Kolehouse, in a field survey on January 5 19 98, do hereby certify that under requirements of P.A. 74 Michigan P.A. of 1970, the corner points mentioned in lines 1 and 2 above were in conformance with regulations and rules therefore as required in the current manual of survey instructions of the United States Department of the interior, Bureau of Land Management or by a decree of a Court of Law and/or that the corner points mentioned in lines 3, 4 and 5 above were in conformance with the rules of the Michigan Board of Land Surveyors or by a Decree of a Court of Law; established, re-established, monumented, re-monumented, recovered, found as expressed below:

NOTE: Not more than 4 corners, all in the same town and range, may be recorded on this certificate.

P.A. 345 1990 KENT COUNTY
PEER APPROVED 2/19/99
CHAIRMAN Harry Hubbell

A. Description of original monument and accessories and/or subsequent restoration:

E-11	1838	G.L.O. Notes	N. Brookfield	Set Post
	1937	Witness Map	K.C. Surveyor	Iron in Box
	1961	Survey	Williams & Works	Monument Box
	1983	L.C.R.C. #3543	T. Chettleburgh	Fnd. Iron Pipe in Mon. Box / Set K.C. Monument
	1991	L.C.R.C. #5846	Exxel Engineering	K.C. Monument

This corner was originally approved by the Kent County Remonumentation Peer Group and monumented by T. Chettleburgh on 8/5/83 and was recorded per L.C.R.C. #3543.

B. Description of corner evidence found and/or method applied in restoring or reestablishing corner:

E-11 Found a Standard Kent County Monument at the C/L intersection of Vergennes Street (bit.) running East and West and Cumberland Avenue (bit.) running South per L.C.R.C.'s #3543 and #5846 as set by T. Chettleburgh in place of an iron pipe he found in a monument box which checked the 1961 Williams & Works survey and the K.C. Surveyor's records.

L.C.R.C. #3543

Nail in S side 15" Maple WNW 72.43'
Nail in E side Power Pole NNW 72.18'

L.C.R.C. #5846

Nail & remon tag in S side 18" Maple N 60°W 72.45' (m. 72.43')
Nail & remon tag in NE side 24" Oak S 24°E 106.45' (m. 106.49')
Nail & remon tag in E side P.Pole N 32°W 72.21' (m. 72.12')
Mon. @ C/L "X" of BT roads to E, W, S

The selected location is accepted by me and is generally accepted by professional surveyors as the best available evidence of the position of the original corner.

C. Description of monument for corner and accessories established to perpetuate locating the position of the corner:

E-11 Standard Kent County Monument

Nail & K.C. remon. tag on S side 18" Maple N 60° W 72.43'
Nail & K.C. remon. tag on NE side 24" Oak S 24° E 106.49'
Nail & K.C. remon. tag on E side P. pole N 32° W 72.12'
Nail & K.C. remon. tag on SE side fence post N 25° E 70.24'
On C/L "X" of bit. roads running E-W-S

STATE OF MICHIGAN
RANDY J. KOLEHOUSE
LAND SURVEYOR
No. 25854
LICENSED LAND SURVEYOR

Signed by Randy J. Kolehouse Date 9-1-98
EARTH TECH
Surveyor's Michigan License No. 25854

FORM APPROVED BY MICHIGAN STATE BOARD OF LAND SURVEYORS, JAN. 28, 1971
REVISED MAY 14, 1975
REVISED JAN., 1983