

SURVEY & REMONUMENTATION

MAR 03 1998

KENT COUNTY REMONUMENTATION

STATE OF MICHIGAN
COUNTY OF KENT
RECEIVED FOR RECORD

97 APR 29 AM 8:28

LAND CORNER RECORDATION CERTIFICATE
Filing Requirement of Act 74, Mich. P.A. 1970

SECTION

For corners in

KENT COUNTY

(County)

Located In:

Corner Code #

1. Public Land Survey	T <u>7</u> N	R <u>9</u> W	E-13
	T	R	
	T	R	
	T	R	
2. Property Controlling in Section	S	T	R
	S	T	R
3. Miscellaneous	S	T	R
Property in Sec.	S	T	R

REG. OF DEEDS

9902

Register of Deeds Stamp & File Number

4. Lot No. _____, Recorded Plat _____
5. Private Claims _____

I, Kirk Breitels, in a field survey on Jan. 6, 1997 do hereby state that under requirements of P.A. 74, Michigan P.A. of 1970, the corner points mentioned in lines 1 and 2 above were in conformance with regulations and rules therefore as required in the current manual of survey instructions of the United States Department of the Interior, Bureau of Land Management or by a decree of a Court of Law and/or that the corner points mentioned in lines 3, 4 and 5 above were in conformance with the rules of the Michigan Board of Land Surveyors or by a Decree of a Court of Law, established, re-established, monumented, recovered, found as expressed below:

NOTE: Not more than 2 corners, all in the same town and range, may be recorded on this certificate.

1	A	B	C	D	E	F	G	H	I	J	K	L	M
2		6		5		4		3		2		1	
3													
4		7		8		9		10		11		12	
5													
6		18		17		16		15		14		13	
7													
8		19		20		21		22		23		24	
9													
10		30		29		28		27		26		25	
11													
12		31		32		33		34		35		36	
13													

A. Description of original monument and accessories and/or subsequent restoration:

E-13	1830	GL0	Mullett	Set Post
	1965	Kent Co. Wit.		1" Iron
	1974	LCRC #699	Spicer	1" Solid Iron
	1981	LCRC #1495	Merdzinski	Set Kent County Monument
	1991	LCRC #5848	Unema	Kent County Monument

The position of this corner was previously approved by the Kent County Remonumentation Peer Group, monumented by John A. Merdzinski on 12/4/80 and was recorded per LCRC #1495

B. Description of corner evidence found and/or method applied in restoring or reestablishing corner:


E-13 Found standard Kent Co. Mon. (Harrison) per witnesses from above LCRC as set by John A. Merdzinski in place of the 1" Iron he found. Said Iron checks with Kent Co. Wit. and LCRC #699.

LCRC #1495		LCRC #5848	
Nail & tag 24" Oak	N30°E 69.82'	Nail & tag 24" Oak	N29°E 69.82'
Nail & tag 10" Oak	N60°W 70.92'	Nail & tag 18" Oak	N60°W 70.92'
Nail & tag 10" Hickory	S40°W 95.51'	Nail & tag 30" Oak	S66°E 92.86'
Nail & tag 20" Maple	S70°W 108.43'	Nail & tag P. Pole	S59°E 66.66'
Nail & tag 30" Oak	S70°E 92.86'	PK Nail & tag curb joint	S30°W 26.45'
Nail & tag P. Pole	N20°W 179.89'	KC Mon. (E-1, T6N, R9W) West	52.76'
Leaded Stone W 52.3' & NW 46.3'			

The selected location is accepted by me and is generally accepted by professional surveyors as the best available evidence of the position of the original corner.

C. Description of monument for corner and accessories established to perpetuate locating the position of the corner:

E-13 Standard Kent County Monument			
Nail & KC Remon. tag E. side 30" Oak	N29°E	69.79'	
Nail & KC Remon. tag SW side 18" Oak	N60°W	70.85'	
Nail & KC Remon. tag N. side 34" Oak	S66°E	92.86'	
Nail & KC Remon. tag N. side P. Pole	S59°E	66.66'	
PK Nail & KC Remon. tag in curb joint	S30°W	26.45'	
Kent Co. Mon. (E-1, T6N, R9W)	West	52.76'	
On C/L BT road to East and West C/L North-South BT road is West 34'±			

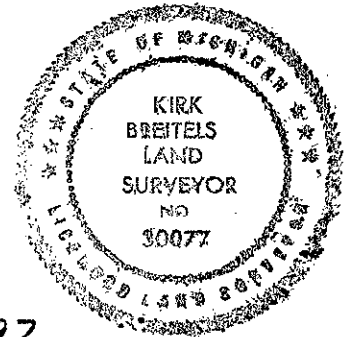

Signed by Kirk Breitels
Surveyor's Michigan License No. 30077

Date 3/27/97

P.A. 345 1990 KENT COUNTY
PEER APPROVED 3/27/97
CHAIRMAN Harry Kuper