

SURVEY & REMONUMENTATION

\$7.00  
\$2.00

MAR 08 1999

LAND CORNER RECORDATION CERTIFICATE  
Filing Requirement of Act 74, Mich. P.A. 1970  
KENT COUNTY REMONUMENTATION


STATE OF MICHIGAN  
COUNTY OF KENT  
RECEIVED FOR RECORD  
38 OCT 23 AM 9:57  
REG. OF DEEDS  
*Lucy J. Koles*

For corners in SECTION \_\_\_\_\_

| Kent<br>(County)                      | Located in: Vergennes<br>Township | Corner Code # |
|---------------------------------------|-----------------------------------|---------------|
| 1. Public Land Survey                 | T <u>7N</u> R <u>9W</u>           | <u>F-1</u>    |
|                                       | T _____ R _____                   | _____         |
|                                       | T _____ R _____                   | _____         |
|                                       | T _____ R _____                   | _____         |
| 2. Property Controlling<br>in Section | S _____ T _____ R _____           | _____         |
|                                       | S _____ T _____ R _____           | _____         |
| 3. Miscellaneous<br>Property in Sec.  | S _____ T _____ R _____           | _____         |
|                                       | S _____ T _____ R _____           | _____         |
| 4. Lot No. _____, Recorded Plat _____ |                                   |               |
| 5. Private Claims _____               |                                   |               |

10766  
Register of Deeds Stamp & File Number

I, Randy Kolehouse, in a field survey on December 31 19 97, do hereby certify that under requirements of P.A. 74 Michigan P.A. of 1970, the corner points mentioned in lines 1 and 2 above were in conformance with regulations and rules therefore as required in the current manual of survey instructions of the United States Department of the interior, Bureau of Land Management or by a decree of a Court of Law and/or that the corner points mentioned in lines 3, 4 and 5 above were in conformance with the rules of the Michigan Board of Land Surveyors or by a Decree of a Court of Law; established, re-established, monumented, re-monumented, recovered, found as expressed below:

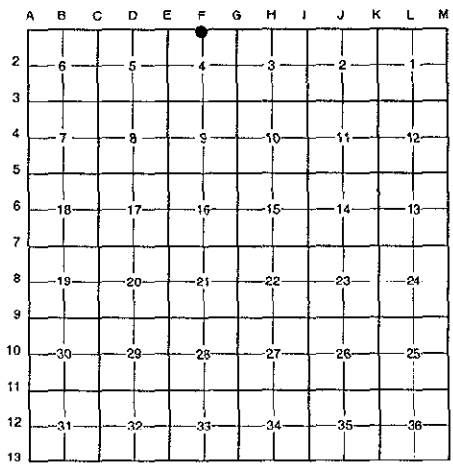

**NOTE: Not more than 4 corners, all in the same town and range, may be recorded on this certificate.**

A. Description of original monument and accessories and/or subsequent restoration:

|     |                                                  |                    |                   |
|-----|--------------------------------------------------|--------------------|-------------------|
| F-1 | This corner was not originally set by the G.L.O. |                    |                   |
|     | 1941 Horseshoe Plat at Murray Lake               | Williams & Works   | N/A               |
|     | 1989 L.C.R.C. #5167                              | R. Kolehouse       | Set K.C. Monument |
|     | 1994 L.C.R.C. #8024                              | Glaza & Associates | K.C. Monument     |

P.A. 345 1990 KENT COUNTY  
PEER APPROVED 2/19/98  
CHAIRMAN Randy Kolehouse

Note: This corner is not common with F-13, T8N, R9W.

This corner was originally approved by the Kent County Remonumentation Peer Group and monumented by Randy Kolehouse on 11/23/85 and was recorded per L.C.R.C. #5167.

B. Description of corner evidence found and/or method applied in restoring or reestablishing corner:


F-1 Found a Standard Kent County Monument 0.2' South of a fence line running East and West and 59' West of the C/L of a bituminous road running North and South per L.C.R.C.'s #5167 and #8024 as set by Randy Kolehouse mid-way between the NW & NE corners of Section 4 on the north line of Horseshoe Plat at Murray Lake as platted by Williams & Work in 1941.

| L.C.R.C. #5167                      | L.C.R.C. #8024                                                           |
|-------------------------------------|--------------------------------------------------------------------------|
| NE Cor. Brick Garage S 45° E 3.55'  | NE corner brick garage S 45° E 3.54'                                     |
| NW Cor. Brick Garage S 75° W 24.35' | NW corner brick garage S 75° W 24.34' (m. 24.36')                        |
| PK in 10" Pear N 20° W 33.1'        | K.C. remon tag & nail in W side 12" Pear Tree N 20° W 33.03' (m. 33.05') |
| Axel Shaft E. 23.95'                | K.C. remon tag & nail in N side P. pole N 90° E 31.33'                   |

The selected location is accepted by me and is generally accepted by professional surveyors as the best available evidence of the position of the original corner.

C. Description of monument for corner and accessories established to perpetuate localizing the position of the corner:

- F-1 Standard Kent County Monument
- NE cor. brick gar. (#3597) S 45° E 3.54'
  - NW cor. brick gar. (#3597) S 75° W 24.36'
  - Nail & K.C. remon. tag on W face 14" Pear Tree N 20° W 33.05'
  - Nail & K.C. remon. tag on N face Util. pole N 90° E 31.33'
  - Fence line running E-W, North 0.2'
  - C/L of bit. road running N-S, East 59.0'
  - K.C. Mon. F-13, T8N, R9W, West 36.95'

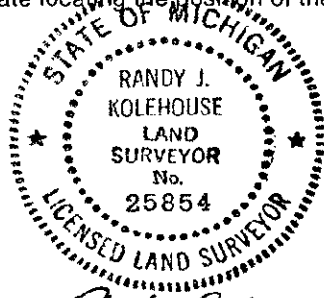

Signed by Randy J. Kolehouse Date 9-1-98  
EARTH TECH

Surveyor's Michigan License No. 25854