

\$7.00
\$2.00

SURVEY &
REMONUMENTATION

MAR 08 1999

LAND CORNER RECORDATION CERTIFICATE
Filing Requirement of Act 74, Mich. P.A. 1970
KENT COUNTY REMONUMENTATION

STATE OF MICHIGAN
COUNTY OF KENT
RECEIVED FOR RECORD
38 DEC 14 AM 8:00
REG. OF DEEDS
Lucy Bond

For corners in Kent SECTION _____
(County)

Located in: Vergennes Corner Code #
Township


1. Public Land Survey	T <u>7N</u>	R <u>9W</u>	<u>F-2</u>
	T _____	R _____	_____
	T _____	R _____	_____
	T _____	R _____	_____
2. Property Controlling in Section	S _____	T _____	R _____
	S _____	T _____	R _____
3. Miscellaneous Property in Sec.	S _____	T _____	R _____
	S _____	T _____	R _____

10937

Register of Deeds Stamp & File Number

- 4. Lot No. _____, Recorded Plat _____
- 5. Private Claims _____

I, Randy Kolehouse, in a field survey on December 29 19 97, do hereby certify that under requirements of P.A. 74 Michigan P.A. of 1970, the corner points mentioned in lines 1 and 2 above were in conformance with regulations and rules therefore as required in the current manual of survey instructions of the United States Department of the Interior, Bureau of Land Management or by a decree of a Court of Law and/or that the corner points mentioned in lines 3, 4 and 5 above were in conformance with the rules of the Michigan Board of Land Surveyors or by a Decree of a Court of Law; established, re-established, monumented, re-monumented, recovered, found as expressed below:

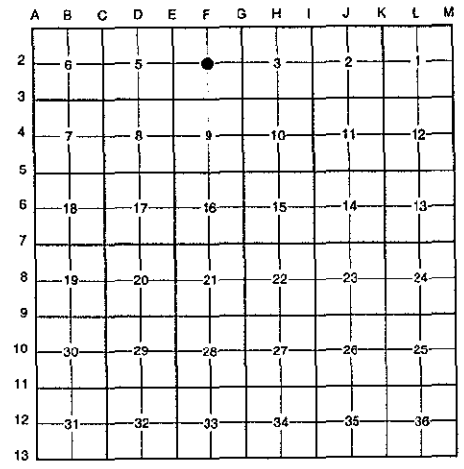

NOTE: Not more than 4 corners, all in the same town and range, may be recorded on this certificate.

A. Description of original monument and accessories and/or subsequent restoration:

F-2	This corner was not originally set by the G.L.O.		
1944	Survey Records	Williams & Works	Set Iron
1967	Witness Map	K.C. Surveyor	3/4" Iron in Mon. Box
1983	Cert. Survey L. 133 P. 46	Exxel Engineering	3/4" Iron in Mon. Box
1983	L.C.R.C. #3228	Exxel Engineering	3/4" Iron in Mon. Box
1987	Cert. Survey L. 189 P. 4	Nederveld Associates	Iron in Mon. Box
1990	Cert. Survey L. 227 P.20	Nederveld Associates	Iron Stake

P.A. 345 1990 KENT COUNTY
PEER APPROVED 10/22/98
CHAIRMAN Randy Kolehouse

B. Description of corner evidence found and/or method applied in restoring or reestablishing corner:

F-2 Found a 3/4" iron in a monument box .50' South of the C/L of Lalley Street (bit.) running East and West per L.C.R.C. #3228 and Cert. Surveys L. 133 P. 46, L. 189 P. 4, and L. 227 P. 20. The found iron also checks the 1944 to 1985 survey records of Williams & Works. Iron is 0.4' South and 0.6' East of the intersection of 1/4 lines. Accepted iron as Center of Section.


L.C.R.C. #3228	Cert. Survey L. 227 P. 20
SE cor hse North 80.20'	SE Cor. Hse. Fndn. N 80.33' (m. 80.18')
SW cor hse NNW 83.68'	SW Cor. Hse. Fndn. NW 87.71' (m. 83.69')
Nail in S side service pole WNW 67.84'	Nail in S. Side P. Pole NW 67.85' (m. 67.83')
Nail in N side P. Pole ESE 85.42'	

The selected location is accepted by me and is generally accepted by professional surveyors as the best available evidence of the position of the original corner.

C. Description of monument for corner and accessories established to perpetuate locating the position of the corner:

F-2 Replaced Iron with a Standard Kent County Monument in a Monument Box

SE cor. Hse. #11585 N 00° E 80.18'
SW cor. Hse. #11585 N 13° W 83.69'
Nail & K.C. remon. tag on S side Service pole N 55° W 67.83'
Nail & K.C. remon. tag on N side P. pole S 64° E 85.40'
C/L of bit. road running E-W, North .50'
Property fence running North, East 6.0'

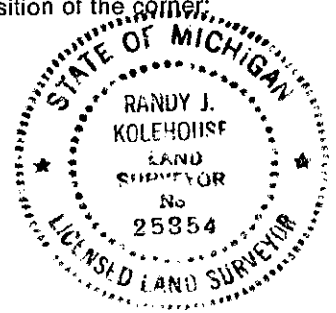

Signed by Randy J. Kolehouse Date 11/18/98
EARTH TECH

Surveyor's Michigan License No. 25854