

MAR 08 1999

\$7.00
\$2.00

LAND CORNER RECORDATION CERTIFICATE
Filing Requirement of Act 74, Mich. P.A. 1970
KENT COUNTY REMONUMENTATION

SECTION

For corners in


Kent (County)	Located in:	Vergennes Township	Corner Code #
1. Public Land Survey	T <u>7N</u>	R <u>9W</u>	<u>F-3</u>
	T _____	R _____	_____
	T _____	R _____	_____
	T _____	R _____	_____
2. Property Controlling in Section	S _____	T _____	R _____
	S _____	T _____	R _____
3. Miscellaneous Property in Sec.	S _____	T _____	R _____
	S _____	T _____	R _____

STATE OF MICHIGAN
COUNTY OF KENT
RECEIVED FOR RECORD
98 DEC 14 AM 8:00
REG. OF DEEDS
Lucy J. Sand

10938
Register of Deeds Stamp & File Number

4. Lot No. _____, Recorded Plat _____
5. Private Claims _____

I, Randy Kolehouse, in a field survey on October 20 19 98, do hereby certify that under requirements of P.A. 74 Michigan P.A. of 1970, the corner points mentioned in lines 1 and 2 above were in conformance with regulations and rules therefore as required in the current manual of survey instructions of the United States Department of the interior, Bureau of Land Management or by a decree of a Court of Law and/or that the corner points mentioned in lines 3, 4 and 5 above were in conformance with the rules of the Michigan Board of Land Surveyors or by a Decree of a Court of Law; established, re-established, monumented, re-monumented, recovered, found as expressed below:

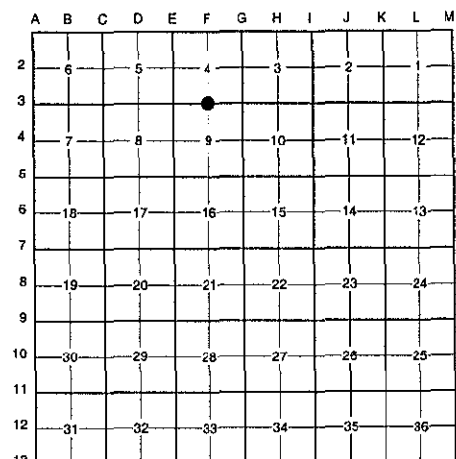

NOTE: Not more than 4 corners, all in the same town and range, may be recorded on this certificate.

- A. Description of original monument and accessories and/or subsequent restoration:
- | | | | | |
|-----|------|----------------|-------------------|---------------------|
| F-3 | 1838 | G.L.O. Notes | N. Brookfield | Set Post |
| | 1983 | L.C.R.C. #3620 | T. Chettleburgh | Set a K.C. Monument |
| | 1991 | L.C.R.C. #5830 | Exxel Engineering | K.C. Monument |

P.A. 345 1990 KENT COUNTY
PEER APPROVED 9/24/98
CHAIRMAN *Harry Huber*

This corner was originally approved by the Kent County Remonumentation Peer Group and monumented by T. Chettleburgh on 11/4/83 and was recorded per L.C.R.C. #3620.

- B. Description of corner evidence found and/or method applied in restoring or reestablishing corner:
- F-3 Found a Standard Kent County Monument in a swamp per L.C.R.C.'s #3620 and #5830 as set by T. Chettleburgh using single proportionate measurement.
- | | |
|---------------------------------------|--|
| L.C.R.C. #3620 | L.C.R.C. #5830 |
| Nail in SE side 9" Elm SW 64.33' | Nail & remon tag in E side 8" Poplar N 24°W 157.25' |
| Nail in NW side 7" Elm WSW 62.51' | Nail & remon tag in SE side 10" Elm (dead) S 44°W 64.40' (m. 64.45') |
| Nail in W side 7" Poplar NNW 159.90' | Nail & remon tag in NW side 8" Elm S 60°W 62.51' (m. 62.53') |
| Nail in W side 12" Poplar NNW 157.00' | Nail & remon tag in 12" Poplar N 15°W 156.9' |

The selected location is accepted by me and is generally accepted by professional surveyors as the best available evidence of the position of the original corner.

- C. Description of monument for corner and accessories established to perpetuate locating the position of the corner:
- F-3 Standard Kent County Monument
- Nail & K.C. remon. tag on SE side 10" Elm (dead) S 45° W 64.45'
 - Nail & K.C. remon. tag on NW side 8" Elm (dead) S 60° W 62.53'
 - Nail & K.C. remon. tag on E side 12" Poplar N 15° W 156.90'
 - Steel fence post N 00° W 1.0'

Signed by *Randy J. Kolehouse* Date 11/18/98
EARTH TECH

Surveyor's Michigan License No. 25854

