

\$7.00  
\$2.00

**SURVEY & REMONUMENTATION**

MAR 08 1999

**LAND CORNER RECORDATION CERTIFICATE**  
Filing Requirement of Act 74, Mich. P.A. 1970  
KENT COUNTY REMONUMENTATION

REG. OF DEEDS

*Lucy Stand*

38 OCT 23 AM 9:57

STATE OF MICHIGAN  
COUNTY OF KENT  
RECEIVED FOR RECORD

For corners in


**SECTION**

Kent (County)	Located in:	Vergennes Township	Corner Code #
1. Public Land Survey	T <u>7N</u> R <u>9W</u>		<u>F-5</u>
	T _____ R _____		_____
	T _____ R _____		_____
	T _____ R _____		_____
2. Property Controlling in Section	S _____ T _____ R _____		_____
	S _____ T _____ R _____		_____
3. Miscellaneous Property in Sec.	S _____ T _____ R _____		_____
	S _____ T _____ R _____		_____

10767

Register of Deeds Stamp & File Number

- 4. Lot No. \_\_\_\_\_, Recorded Plat \_\_\_\_\_
- 5. Private Claims \_\_\_\_\_

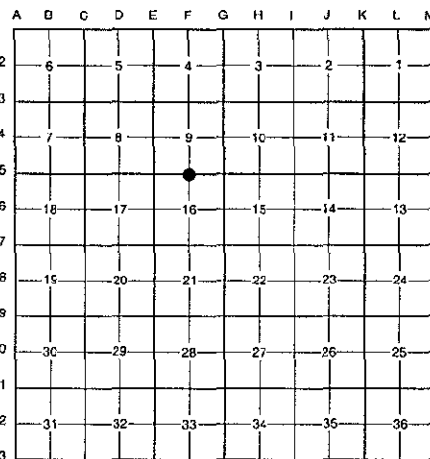

I, Randy Kolehouse, in a field survey on December 26 19 97, do hereby certify that under requirements of P.A. 74 Michigan P.A. of 1970, the corner points mentioned in lines 1 and 2 above were in conformance with regulations and rules therefore as required in the current manual of survey instructions of the United States Department of the interior, Bureau of Land Management or by a decree of a Court of Law and/or that the corner points mentioned in lines 3, 4 and 5 above were in conformance with the rules of the Michigan Board of Land Surveyors or by a Decree of a Court of Law; established, re-established, monumented, re-monumented, recovered, found as expressed below:

**NOTE: Not more than 4 corners, all in the same town and range, may be recorded on this certificate.**

**A. Description of original monument and accessories and/or subsequent restoration:**

F-5	1838	G.L.O. Notes	N. Brookfield	Set Post
	1965	Witness Map	K.C. Surveyor	Concrete Monument
	1973	L.C.R.C. #399	Williams & Works	1" Iron
	1981	L.C.R.C. #1936	Jonker Land Survey	Fnd. 1" Iron in Conc. Mon. / Set K.C. Monument
	1991	L.C.R.C. #5831	Exxel Engineering	K.C. Monument

P.A. 345 1990 KENT COUNTY

PEER APPROVED *2/19/98*

CHAIRMAN *Randy Kolehouse*

This corner was originally approved by the Kent County Remonumentation Peer Group and monumented by Rob Jonker on 8/6/98 and was recorded per L.C.R.C. #1936.

**B. Description of corner evidence found and/or method applied in restoring or reestablishing corner:**

F-5 Found a Standard Kent County Monument 3.0' North of the C/L of 2 Mile Road (gravel) running East and West, on line of a tree row and the remains of an old fence line running North, per L.C.R.C.'s #1936 and #5831 as set by Rob Jonker in place of a 1" iron he found in the top of a concrete monument which checked L.C.R.C. #399 and the K.C. Surveyor's records.

L.C.R.C. #1936

L.C.R.C. #5831

Remon. tag on W side 6" Hickory N05°W 23.88'  
Remon. tag on S side tw. 18" Maple N72°E 35.58'  
Remon. tag on W side 13" Hickory S04°W 46.84'  
Remon. tag on SE side 16" Maple S51°W 71.45'

Nail & KC tag in W side 8" Hickory N 04°W 23.77' (m. 23.80')  
Nail & KC tag in N side 16" quad Maple S 59°W 34.70' (m. 34.74')  
Nail & KC tag in S side 20" twin-Maple N 74°E 35.09' (m. 35.04')  
Nail & KC tag in W side 16" Hickory S 06°W 46.90' (m. 46.89')  
Nail & KC tag in SE side 20" Maple S 51°W 71.55' (m. 71.50')

The selected location is accepted by me and is generally accepted by professional surveyors as the best available evidence of the position of the original corner.

**C. Description of monument for corner and accessories established to perpetuate locating the position of the corner:**

**F-5 Standard Kent County Monument**

Nail & K.C. remon. tag on W side 8" Hickory N 04° W 23.80'  
Nail & K.C. remon. tag on N side 16" quad. Maple S 59° W 34.74'  
Nail & K.C. remon. tag on S side 20" twin Maple N 74° E 35.04'  
Nail & K.C. remon. tag on W side 16" Hickory S 06° W 46.89'  
Nail & K.C. remon. tag on SE side 20" Maple S 51° W 71.50'  
C/L of gravel road running E-W, South 3.0'  
On tree row and old fence line running N



Signed by *Randy J. Kolehouse*

Date 9-1-98

EARTH TECH

Surveyor's Michigan License No. 25854