

MAR 8 1999

\$7.00  
\$2.00

**SECTION LAND CORNER RECORDATION CERTIFICATE**  
Filing Requirement of Act 74, Mich. P.A. 1970  
KENT COUNTY REMONUMENTATION

STATE OF MICHIGAN  
COUNTY OF KENT  
RECEIVED FOR RECORD  
38 OCT 23 AM 9:57  
REG. OF DEEDS  
*Lucy Bond*

10769

Register of Deeds Stamp & File Number

For corners in Kent (County) Located in: Vergennes Township Corner Code #


1. Public Land Survey T 7N R 9W F-9  
T \_\_\_\_\_ R \_\_\_\_\_  
T \_\_\_\_\_ R \_\_\_\_\_  
T \_\_\_\_\_ R \_\_\_\_\_

2. Property Controlling in Section S \_\_\_\_\_ T \_\_\_\_\_ R \_\_\_\_\_  
S \_\_\_\_\_ T \_\_\_\_\_ R \_\_\_\_\_

3. Miscellaneous Property in Sec. S \_\_\_\_\_ T \_\_\_\_\_ R \_\_\_\_\_  
S \_\_\_\_\_ T \_\_\_\_\_ R \_\_\_\_\_

4. Lot No. \_\_\_\_\_, Recorded Plat \_\_\_\_\_

5. Private Claims \_\_\_\_\_

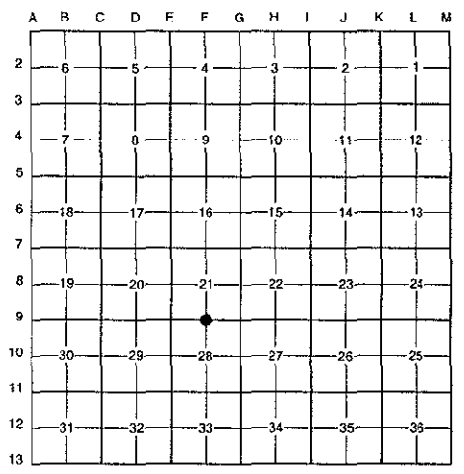

Randy Kolehouse, in a field survey on January 6 19 98, do hereby certify that under requirements of P.A. 74 Michigan P.A. of 1970, the corner points mentioned in lines 1 and 2 above were in conformance with regulations and rules therefore as required in the current manual of survey instructions of the United States Department of the Interior, Bureau of Land Management or by a decree of a Court of Law and/or that the corner points mentioned in lines 3, 4 and 5 above were in conformance with the rules of the Michigan Board of Land Surveyors or by a Decree of a Court of Law; established, re-established, monumented, re-monumented, recovered, found as expressed below:

**NOTE: Not more than 4 corners, all in the same town and range, may be recorded on this certificate.**

A. Description of original monument and accessories and/or subsequent restoration:

F-9	1838	G.L.O. Notes	N. Brookfield	Set Post
	1963	Witness Map	K.C. Surveyor	1" Iron
	1971	L.C.R.C. #59	Williams & Works	"T" Iron
	1981	L.C.R.C. #1938	Jonker Land Survey	Fnd. "T" Iron / Set K.C. Monument
	1991	L.C.R.C. #5833	Exxel Engineering	K.C. Monument

P.A. 345 1990 KENT COUNTY  
PEER APPROVED 2/19/98  
CHAIRMAN *[Signature]*

This corner was originally approved by the Kent County Remonumentation Peer Group and monumented by Rob Jonker on 8/5/81 and was recorded per L.C.R.C. #1938.

B. Description of corner evidence found and/or method applied in restoring or reestablishing corner:  
F-9 Found a Standard Kent County Monument 1' South of the C/L of Bailey Road (bit.) running East and West, on line of a fence line running South and a tree row running North, per L.C.R.C.'s #1938 and #5833 as set by Rob Jonker in place of a "T" iron he found which checked L.C.R.C. #59 and the K.C. Surveyor's records.

L.C.R.C. #1938	L.C.R.C. #5833
Remon. Tag on SW side 9" Pine N48°W 59.95' (m. 59.97')	Nail & remon tag in SE side 12" Maple S 34°W 59.47' (m. 59.45')
Chisled "X" on S end conc. Road culv. S72°E 78.64' (m. 78.68')	Nail & remon tag in W side 16" Oak N 17°E 71.89' (m. 71.87')
Chisled "X" on N end conc. Road culv. N76°E 77.31' (m. 77.32')	Nail & remon tag in SW side 12" Pine N 48°W 59.97'
	"X" on S end conc. Culv. S 71°E 78.67' (m. 78.68')
	"X" on N end conc. Culv. N 77°E 77.33' (m. 77.32')

The selected location is accepted by me and is generally accepted by professional surveyors as the best available evidence of the position of the original corner.

C. Description of monument for corner and accessories established to perpetuate locating the position of the corner:

- F-9 Standard Kent County Monument \*\*
- Nail & K.C. remon. tag on SE side 12" Maple S 34° W 59.45'
  - Nail & K.C. remon. tag on W side 16" Oak N 17° E 71.87'
  - Nail & K.C. remon. tag on SW side 12" Pine N 48° W 59.97'
  - Nail & K.C. remon. tag on N side 8" Pine S 54° W 92.56'
  - "X" cut on S end conc. culvert S 71° E 78.68'
  - "X" cut on N end conc. culvert N 77° E 77.32'
  - C/L bit. road running E-W, North 1.0'
  - On fence line running S
  - On tree row running N



Signed by *Randy J. Kolehouse* Date 9-1-98

Surveyor's Michigan License No. 25854