

MAR 08 1999

SECTION

LAND CORNER RECORDATION CERTIFICATE

Filing Requirement of Act 74, Mich. P.A. 1970

KENT COUNTY REMONUMENTATION


For corners in

Kent (County)	Located in: Vergennes Township	Corner Code #
1. Public Land Survey	T <u>7N</u> R <u>9W</u>	<u>F-11</u>
	T _____ R _____	_____
	T _____ R _____	_____
	T _____ R _____	_____
2. Property Controlling in Section	S _____ T _____ R _____	_____
	S _____ T _____ R _____	_____
3. Miscellaneous Property in Sec.	S _____ T _____ R _____	_____
	S _____ T _____ R _____	_____

STATE OF MICHIGAN
COUNTY OF KENT
RECEIVED FOR RECORD
98 OCT 23 AM 9:57
REG. OF DEEDS
10770
Register of Deeds Stamp & File Number

4. Lot No. _____, Recorded Plat _____
5. Private Claims _____

I, Randy Kolehouse, in a field survey on January 6 19 98, do hereby certify that under requirements of P.A. 74 Michigan P.A. of 1970, the corner points mentioned in lines 1 and 2 above were in conformance with regulations and rules therefore as required in the current manual of survey instructions of the United States Department of the interior, Bureau of Land Management or by a decree of a Court of Law and/or that the corner points mentioned in lines 3, 4 and 5 above were in conformance with the rules of the Michigan Board of Land Surveyors or by a Decree of a Court of Law; established, re-established, monumented, re-monumented, recovered, found as expressed below:

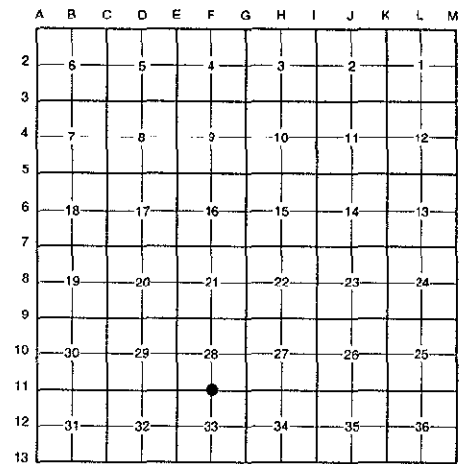

NOTE: Not more than 4 corners, all in the same town and range, may be recorded on this certificate.

A. Description of original monument and accessories and/or subsequent restoration:

F-11	1838	G.L.O. Notes	N. Brookfield	18" White Oak
	1947	Witness Map	K.C. Surveyor	2-1/2" Iron in Box
	1984	L.C.R.C. #3890	R. Kolehouse	Fnd. 2-1/2" Iron in Mon. Box / Set Cap & Riser
	1991	L.C.R.C. #5834	Exxel Engineering	K.C. Monument

P.A. 345 1990 KENT COUNTY
PEER APPROVED 2/19/98
CHAIRMAN Randy Kolehouse
Harry Huber

This corner was originally approved by the Kent County Remonumentation Peer Group and monumented by Randy Kolehouse on 8/18/84 and was recorded per L.C.R.C. #3890.

3. Description of corner evidence found and/or method applied in restoring or reestablishing corner:
F-11 Found a Kent County riser and cap over a 2-1/2" iron 1.2' North of the C/L of Vergennes Street (bit.) running East and West, on line of a tree row running North and South and a fence line running North, per L.C.R.C.'s #3890 and #5834 as set by Randy Kolehouse on top of the 2-1/2" iron he found which checked the K.C. Surveyor's records.

L.C.R.C. #3890

L.C.R.C. #5834


Nail & K.C. Remon. Tag in E. side twin 12" Hickory N. 29.05'
Nail & K.C. Remon. Tag in S. side 20" Oak N 70 W 71.10'
Nail & K.C. Remon. Tag in NW side 12" Oak S 45 W 36.79'

Nail & remon tag in E side 12" Twin Hickory North 29.03' (m. 29.00')
Nail & remon tag in S side 24" Oak N 70°W 71.10' (m. 71.09')
Nail & remon tag in NW side 14" Oak S 45° W 36.77' (m. 36.76')

The selected location is accepted by me and is generally accepted by professional surveyors as the best available evidence of the position of the original corner.

2. Description of monument for corner and accessories established to perpetuate locating the position of the corner:

F-11 Standard Kent County Riser & Cap Over a 2-1/2" Iron
Nail & K.C. remon. tag on E side 12" Twin Hickory North 29.00'
Nail & K.C. remon. tag on S side 24" Oak N 70° W 71.09'
Nail & K.C. remon. tag on NW side 14" Oak S 45° W 36.76'
Nail & K.C. remon. tag on E side 14" Maple S 05° W 48.11'
C/L bit. road E-W, South 1.2'
On tree row running N-S
On fence line running N

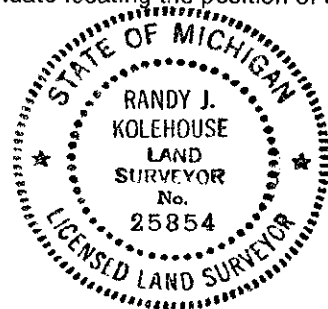

igned by Randy Kolehouse
EARTH TECH

Date 9-1-98

urveyor's Michigan License No. 25854