

**SURVEY & REMONUMENTATION**

MAR 03 1998

KENT COUNTY REMONUMENTATION

**LAND CORNER RECORDATION CERTIFICATE**  
Filing Requirement of Act 74, Mich. P.A. 1970

**SECTION**

For corners in

KENT COUNTY

(County)

Located In:

Corner Code #

|                                    |                         |       |
|------------------------------------|-------------------------|-------|
| 1. Public Land Survey              | T <u>7N</u> R <u>9W</u> | F-13  |
|                                    | T ___ R ___             | _____ |
|                                    | T ___ R ___             | _____ |
|                                    | T ___ R ___             | _____ |
| 2. Property Controlling in Section | S ___ T ___ R ___       | _____ |
|                                    | S ___ T ___ R ___       | _____ |
| 3. Miscellaneous Property in Sec.  | S ___ T ___ R ___       | _____ |
|                                    | S ___ T ___ R ___       | _____ |

STATE OF MICHIGAN  
COUNTY OF KENT  
RECEIVED FOR RECORD

97 JUN -3 AM 8:11

REG. OF DEEDS  
*Luis J. Bond*

10000

Register of Deeds Stamp & File Number

4. Lot No. \_\_\_\_\_, Recorded Plat \_\_\_\_\_  
5. Private Claims \_\_\_\_\_

I, Kirk Breitels, in a field survey on May 13, 1997 do hereby state that under requirements of P.A. 74, Michigan P.A. of 1970, the corner points mentioned in lines 1 and 2 above were in conformance with regulations and rules therefore as required in the current manual of survey instructions of the United States Department of the Interior, Bureau of Land Management or by a decree of a Court of Law and/or that the corner points mentioned in lines 3, 4 and 5 above were in conformance with the rules of the Michigan Board of Land Surveyors or by a Decree of a Court of Law; established, re-established, monumented, recovered, found as expressed below:

NOTE: Not more than 2 corners, all in the same town and range, may be recorded on this certificate.

|    |    |   |    |   |    |   |    |   |    |   |    |   |   |
|----|----|---|----|---|----|---|----|---|----|---|----|---|---|
|    | A  | B | C  | D | E  | F | G  | H | I  | J | K  | L | M |
| 1  |    |   |    |   |    |   |    |   |    |   |    |   |   |
| 2  | 6  |   | 5  |   | 4  |   | 3  |   | 2  |   | 1  |   |   |
| 3  |    |   |    |   |    |   |    |   |    |   |    |   |   |
| 4  | 7  |   | 8  |   | 9  |   | 10 |   | 11 |   | 12 |   |   |
| 5  |    |   |    |   |    |   |    |   |    |   |    |   |   |
| 6  | 10 |   | 17 |   | 16 |   | 15 |   | 14 |   | 13 |   |   |
| 7  |    |   |    |   |    |   |    |   |    |   |    |   |   |
| 8  | 19 |   | 20 |   | 21 |   | 22 |   | 23 |   | 24 |   |   |
| 9  |    |   |    |   |    |   |    |   |    |   |    |   |   |
| 10 | 30 |   | 29 |   | 28 |   | 27 |   | 26 |   | 25 |   |   |
| 11 |    |   |    |   |    |   |    |   |    |   |    |   |   |
| 12 | 31 |   | 32 |   | 33 |   | 34 |   | 35 |   | 36 |   |   |
| 13 |    |   |    |   |    |   |    |   |    |   |    |   |   |

A. Description of original monument and accessories and/or subsequent restoration:

|      |         |                  |         |                            |
|------|---------|------------------|---------|----------------------------|
| F-13 | 1830    | GLO              | Mullett | Set Post                   |
|      | 1937    | Kent Co. Wit.    |         | Iron                       |
|      | 1954-75 | Williams & Works |         | Iron                       |
|      | 1985    | LCRC #4147       | Rosema  | Set Kent County Monument   |
|      | 1991    | LCRC #5835       | Uneima  | Reset Kent County Monument |

The position of this corner was previously approved by the Kent County Remonumentation Peer Group, monumented by Maurice J. Rosema on 3/7/85 and was recorded per LCRC #4147

B. Description of corner evidence found and/or method applied in restoring or reestablishing corner:

F-13 Found BROKEN standard Kent Co. Mon. (Harrison) over Kent Co. Mon. 30" deep per above LCRC, set by Maurice Rosema in place of the 3/4" Iron he found. Said Iron checks Williams & Works info. & Kent Co. Wit. Removed/Reset Kent Co. Mon. over the Kent Co. Mon. 30" deep.

|                       |              |                        |              |
|-----------------------|--------------|------------------------|--------------|
| <u>LCRC #4147</u>     |              | <u>LCRC #5835</u>      |              |
| Nail & tag 10" Cherry | N01°E 23.50' | Nail & tag 14" Oak     | S50°W 71.97' |
| Nail & tag 14" Poplar | N40°W 32.51' | Nail & tag 14" Maple   | S63°E 96.17' |
| Nail & tag 8" Maple   | N62°E 54.04' | Nail & tag 18" Hickory | S00°E 46.38' |
| Nail & tag 12" Maple  | S63°E 96.17' | Nail & tag 14" Maple   | S50°E 77.78' |
| KC Mon. (F-1, 6-9)    | West 71.41'  | KC Mon. (F-1, 6-9)     | West 71.41'  |


The selected location is accepted by me and is generally accepted by professional surveyors as the best available evidence of the position of the original corner.

C. Description of monument for corner and accessories established to perpetuate locating the position of the corner:

F-13 Standard Kent County Monument

|                               |             |       |        |
|-------------------------------|-------------|-------|--------|
| Nail & KC Remon. tag NW side  | 16" Oak     | S50°W | 72.00' |
| Nail & KC Remon. tag NE side  | 16" Maple   | S63°E | 96.17' |
| Nail & KC Remon. tag E. side  | 20" Hickory | S00°E | 46.36' |
| Nail & KC Remon. tag NE side  | 16" Maple   | S50°E | 77.81' |
| Kent Co. Mon. (F-1, T6N, R9W) |             | West  | 71.41' |

On C/L E-W asphalt road & tree row N.

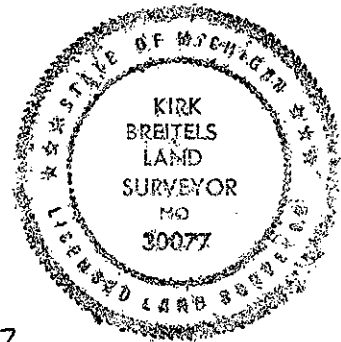

Signed by *Kirk Breitels*  
Surveyor's Michigan License No. 30077

Date 5/22/97

P.A. 345 1980 KENT COUNTY  
PEER APPROVED 5/22/97  
CHAIRMAN *Harry Hubbell*