

MAR 08 1999

SECTION

**LAND CORNER RECORDATION CERTIFICATE**  
**Filing Requirement of Act 74, Mich. P.A. 1970**  
**KENT COUNTY REMONUMENTATION**

For corners in

Kent (County)	Located in: Vergennes Township	Corner Code #
1. Public Land Survey	T <u>7N</u> R <u>9W</u>	<u>G-1</u>
	T _____ R _____	_____
	T _____ R _____	_____
	T _____ R _____	_____
2. Property Controlling in Section	S _____ T _____ R _____	_____
	S _____ T _____ R _____	_____
3. Miscellaneous Property in Sec.	S _____ T _____ R _____	_____
	S _____ T _____ R _____	_____

STATE OF MICHIGAN  
 COUNTY OF KENT  
 RECEIVED FOR RECORD

38 DEC 14 AM 8:00

REG. OF DEEDS  
*W. J. Bond*


**10941**

Register of Deeds Stamp & File Number

4. Lot No. \_\_\_\_\_, Recorded Plat \_\_\_\_\_  
 5. Private Claims \_\_\_\_\_

I, Randy Kolehouse, in a field survey on Jan 8 19 98, do hereby certify that under requirements of P.A. 74 Michigan P.A. of 1970, the corner points mentioned in lines 1 and 2 above were in conformance with regulations and rules therefore as required in the current manual of survey instructions of the United States Department of the interior, Bureau of Land Management or by a decree of a Court of Law and/or that the corner points mentioned in lines 3, 4 and 5 above were in conformance with the rules of the Michigan Board of Land Surveyors or by a Decree of a Court of Law; established, re-established, monumented, re-monumented, recovered, found as expressed below:

**NOTE: Not more than 4 corners, all in the same town and range, may be recorded on this certificate.**

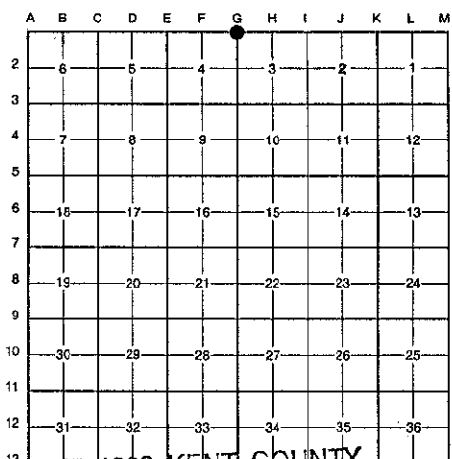

A. Description of original monument and accessories and/or subsequent restoration:

G-1	1837	G.L.O. Notes	N. Brookfield	Set Post
	1941-1964	Witness Map	K.C. Surveyor	1-1/2" Pipe
	1976	L.C.R.C. #995	Medema, Van Kooten & Assoc.	1-1/2" Iron (G-13, T8N, R9W)
	1980	L.C.R.C. #1355	Williams & Works	1" Iron
	1981	L.C.R.C. #1783	Williams & Works	Fnd. 1-1/2" Iron Pipe / Set K.C. Mon. (G-13, T8N, R9W)
	1994	L.C.R.C. #8044	Glaza & Associates	K.C. Monument (G-13, T8N, R9W)

P.A. 345 1990 KENT COUNTY  
 PEER APPROVED 9/24/98  
 CHAIRMAN *[Signature]*

Note: This corner is common with G-13, T8N, R9W.

This corner was originally approved by the Kent County Remonumentation Peer Group and monumented by Williams & Works on 1/26/81 and was recorded per L.C.R.C. #1783.

B. Description of corner evidence found and/or method applied in restoring or reestablishing corner:

G-1 Found a Standard Kent County Monument on the C/L of Alden Nash (bit.) extended North and running South and on the C/L of 4 Mile Road (bit.) extended West and running East per L.C.R.C.'s #1783 and #8044 as set by Williams & Works in place of a 1-1/2" iron pipe they found which checked L.C.R.C.'s #1355, #995 and the K.C. Surveyor's records.

L.C.R.C. #1783

L.C.R.C. #8044

K.C. Remon. Tag & Nail in NW Side T&P Pole N 60° E 63.61'  
 K.C. Remon. Tag & Nail in S. Side 10" Spruce N 55° W 48.22'  
 K.C. Remon. Tag & Nail in N. Side 10" Spruce S 85° W 44.02'  
 K.C. Remon. Tag & Nail in E. Side P. Pole S 20° W 118.34'  
 SW Cor. Hse. Fnd. N 05° W 86.16'


K.C. remon tag & nail in SE side T&P Pole N 60° E 63.75' (63.72')  
 K.C. remon tag & nail in S side 18" Spruce N 55° W 48.01' (m. 48.02')  
 K.C. remon tag & nail in N side 18" Spruce S 85° W 43.84' (m. 43.82')  
 K.C. remon tag & nail in E side P. Pole S 20° W 118.40' (m. 118.42')  
 SW corner house foundation N 05° W 86.10' (m. 86.12')

The selected location is accepted by me and is generally accepted by professional surveyors as the best available evidence of the position of the original corner.

C. Description of monument for corner and accessories established to perpetuate locating the position of the corner:

G-1 Standard Kent County Monument

Nail & K.C. remon. tag on SE side P. pole N 60° E 63.72'  
 Nail & K.C. remon. tag on S side 14" Spruce N 55° W 48.02'  
 Nail & K.C. remon. tag on N side 14" Spruce S 85° W 43.82'  
 Nail & K.C. remon. tag on E side P. pole S 20° W 118.42'  
 Nail & K.C. remon. tag on N side P. pole S 75° E 122.43'  
 Fnd. SW cor. hse. fndn. N 15° W 86.12'

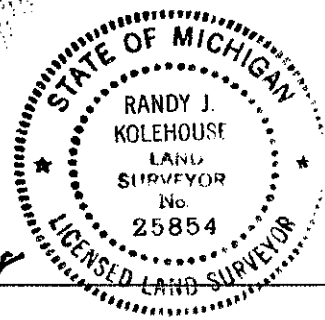

Signed by Randy J. Kolehouse  
 EARTH TECH

Date 11/18/98

Surveyor's Michigan License No. 25854