

SURVEY & REMONUMENTATION

~~\$7.00~~
\$2.00

MAR 08 1999

LAND CORNER RECORDATION CERTIFICATE
Filing Requirement of Act 74, Mich. P.A. 1970
KENT COUNTY REMONUMENTATION

For corners in

SECTION


Kent (County)	Located in:	Vergennes Township	Corner Code #
1. Public Land Survey	T <u>7N</u>	R <u>9W</u>	<u>G-2</u>
	T _____	R _____	_____
	T _____	R _____	_____
	T _____	R _____	_____
2. Property Controlling in Section	S _____	T _____	R _____
	S _____	T _____	R _____
3. Miscellaneous Property in Sec.	S _____	T _____	R _____
	S _____	T _____	R _____

STATE OF MICHIGAN
COUNTY OF KENT
RECEIVED FOR RECORD
98 OCT 23 AM 9:57
REG. OF DEEDS
Lucy Bond

10771
Register of Deeds Stamp & File Number

4. Lot No. _____, Recorded Plat _____
5. Private Claims _____

I, Randy Kolehouse, in a field survey on December 30 19 97, do hereby certify that under requirements of P.A. 74 Michigan P.A. of 1970, the corner points mentioned in lines 1 and 2 above were in conformance with regulations and rules therefore as required in the current manual of survey instructions of the United States Department of the interior, Bureau of Land Management or by a decree of a Court of Law and/or that the corner points mentioned in lines 3, 4 and 5 above were in conformance with the rules of the Michigan Board of Land Surveyors or by a Decree of a Court of Law; established, re-established, monumented, re-monumented, recovered, found as expressed below:

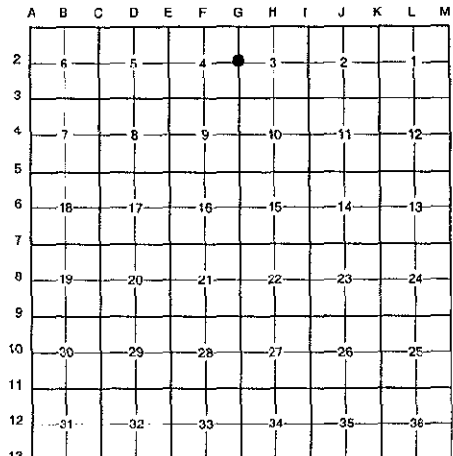

NOTE: Not more than 4 corners, all in the same town and range, may be recorded on this certificate.

A. Description of original monument and accessories and/or subsequent restoration:

G-2	1838	G.L.O. Notes	N. Brookfield	Set Post
	1963	Witness Map	K.C. Surveyor	Stone & Iron
	1980	L.C.R.C. #1355	Williams & Works	Stone & Iron in Mon. Box
	1981	L.C.R.C. #1939	Jonker Land Survey	Fnd. 7/8" Iron in Mon. Box / Set K.C. Mon. in Mon. Box
	1991	L.C.R.C. #5785	Exxel Engineering	K.C. Monument in Mon. Box

P.A. 345 1990 KENT COUNTY

PEER APPROVED 2/19/98
CHAIRMAN Harry Huber

This corner was originally approved by the Kent County Remonumentation Peer Group and monumented by Rob Jonker on 8/7/81 and was recorded per L.C.R.C. #1939.

B. Description of corner evidence found and/or method applied in restoring or reestablishing corner:

G-2 Found a Standard Kent County Monument in a monument box at the C/L intersection of Alden Nash (bit.) running North and South and Lally Street (gravel) running West per L.C.R.C.'s #1939 and #5785 as set by Rob Jonker in place of a 7/8" iron he found in a monument box which checked L.C.R.C. #1355 and the K.C. Surveyor's records.

L.C.R.C. #1939

L.C.R.C. #5785

Remon. tag on S side p.pole N60°W 94.80'
Remon. tag on W side 14" Hickory N09°E 182.10'
P.K. on curb crack S51°W 36.62'


PK nail in curb joint N 28°W 39.57' (m. 39.56')
PK nail in top SE cor of conc. Culv. Head wall N 36°E 32.42' (m. 32.49')
Nail & remon tag in S side P.Pole N 59°W 94.77' (m. 94.80')
PK nail in curb crack S 51°W 36.61'

The selected location is accepted by me and is generally accepted by professional surveyors as the best available evidence of the position of the original corner.

C. Description of monument for corner and accessories established to perpetuate locating the position of the corner:

G-2 Standard Kent County Monument in a Monument Box

- Nail & K.C. remon. tag on curb joint N 28° W 39.56'
- Nail & K.C. remon. tag on top SE cor. of conc. culvert headwall N 36° E 32.49'
- Nail & K.C. remon. tag on S side P. pole N 59° W 94.80'
- Nail & K.C. remon. tag on curb joint S 51° W 36.61'
- Nail & K.C. remon. tag on W side 14" Hickory N 09° E 182.12'
- Nail & K.C. remon. tag on NW side clump 6" Elms S 71° W 75.24'
- On C/L "X" bit. road running N-S and gravel road running W

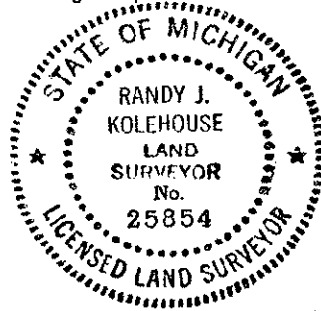

Signed by Randy J. Kolehouse Date 9-1-98

EARTH TECH

Surveyor's Michigan License No. 25854