

SURVEY & REMONUMENTATION

\$7.00
\$2.00

MAR 08 1999

LAND CORNER RECORDATION CERTIFICATE
Filing Requirement of Act 74, Mich. P.A. 1970
KENT COUNTY REMONUMENTATION

SECTION

For corners in

Kent (County)	Located in: Vergennes Township	Corner Code #
1. Public Land Survey	T <u>7N</u> R <u>9W</u>	<u>G-3</u>
	T _____ R _____	_____
	T _____ R _____	_____
	T _____ R _____	_____
2. Property Controlling in Section	S _____ T _____ R _____	_____
	S _____ T _____ R _____	_____
3. Miscellaneous Property in Sec.	S _____ T _____ R _____	_____
	S _____ T _____ R _____	_____

STATE OF MICHIGAN
COUNTY OF KENT
RECEIVED FOR RECORD

98 OCT 23 AM 9:57

REG. OF DEEDS
Eric Sand

10772

Register of Deeds Stamp & File Number


- 4. Lot No. _____, Recorded Plat _____
- 5. Private Claims _____

I, Randy Kolehouse, in a field survey on December 29 19 987, do hereby certify that under requirements of P.A. 74 Michigan P.A. of 1970, the corner points mentioned in lines 1 and 2 above were in conformance with regulations and rules therefore as required in the current manual of survey instructions of the United States Department of the interior, Bureau of Land Management or by a decree of a Court of Law and/or that the corner points mentioned in lines 3, 4 and 5 above were in conformance with the rules of the Michigan Board of Land Surveyors or by a Decree of a Court of Law; established, re-established, monumented, re-monumented, recovered, found as expressed below:

NOTE: Not more than 4 corners, all in the same town and range, may be recorded on this certificate.

A. Description of original monument and accessories and/or subsequent restoration:

G-3	1838	G.L.O. Notes	N. Brookfield	Set Post
	1961	Witness Map	K.C. Surveyor	N/A
	1983	L.C.R.C. #3371	J. Bueche	Concrete Nail
	1983	L.C.R.C. #3485	J. Bueche	Fnd. Concrete Nail / Set K.C. Monument
	1991	L.C.R.C. #5786	Exxel Engineering	K.C. Monument

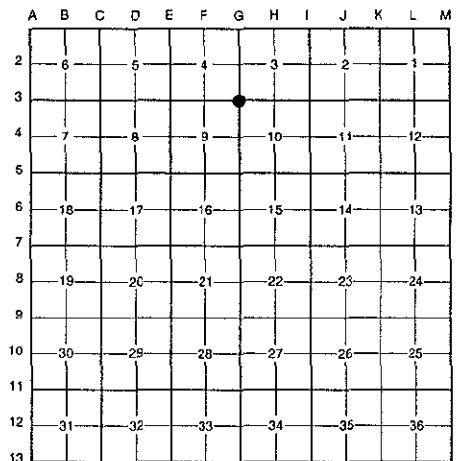

P.A. 345 1990 KENT COUNTY
PEER APPROVED 2/19/98
CHAIRMAN Randy Kolehouse

This corner was originally approved by the Kent County Remonumentation Peer Group and monumented by J. Bueche on 7/25/83 and was recorded per L.C.R.C. #3485.

B. Description of corner evidence found and/or method applied in restoring or reestablishing corner:

G-3 Found a Standard Kent County Monument .5' East of the C/L of Alden Nash (bit.) running North and South and 205' ± North of the C/L of 3 Mile Road (gravel) running East per L.C.R.C.'s #3485 and #5786 as set by J. Bueche in place of a concrete nail he found which checked L.C.R.C. #3371 and the K.C. Surveyor's records.

L.C.R.C. #3485

Nail in N.W. side 18" Ash N 30° E 75.30'
Nail in N side 24" dbl. Willow N 75° W 38.3'

L.C.R.C. #5786

Nail & remon tag in NW side 20" Ash N 30°E ;75.12' (m. 75.07')
Nail & remon tag in N side 30" twin Willow N 80°E 39.46' (m. 39.12')
Nail & remon tag in NE side 8" quad Elm N 30°W 53.55' (m. 53.22')

The selected location is accepted by me and is generally accepted by professional surveyors as the best available evidence of the position of the original corner.

C. Description of monument for corner and accessories established to perpetuate locating the position of the corner:

G-3 Standard Kent County Monument

- Nail & K.C. remon. tag on NW side 20" Ash N 30° E 75.07'
- Nail & K.C. remon. tag on N side 30" Twin Willow N 80° E 39.12'
- Nail & K.C. remon. tag on NE side 8" Quad. Elm N 30° W 53.22'
- Nail & K.C. remon. tag on SW side 14" Elm (dead) S 12° E 98.86'
- C/L of bit. road N-S, West .5'
- C/L of gravel road running E, South 205'



Signed by Randy J. Kolehouse
EARTH TECH

Date 9-1-98

Surveyor's Michigan License No. 25854