

\$7.00
\$2.00

MAR 08 1999

SECTION

LAND CORNER RECORDATION CERTIFICATE

Filing Requirement of Act 74, Mich. P.A. 1970

KENT COUNTY REMONUMENTATION

For corners in

Kent (County)	Located in: Vergennes Township	Corner Code #
1. Public Land Survey	T <u>7N</u> R <u>9W</u>	<u>G-4</u>
	T _____ R _____	_____
	T _____ R _____	_____
	T _____ R _____	_____
2. Property Controlling in Section	S _____ T _____ R _____	_____
	S _____ T _____ R _____	_____
3. Miscellaneous Property in Sec.	S _____ T _____ R _____	_____
	S _____ T _____ R _____	_____

STATE OF MICHIGAN
COUNTY OF KENT
RECEIVED FOR RECORDS
38 OCT 23 AM 9:57
REG. OF DEEDS
Tim J. Bueche

10773

Register of Deeds Stamp & File Number


- 4. Lot No. _____, Recorded Plat _____
- 5. Private Claims _____

I, Randy Kolehouse, in a field survey on December 29 19 97, do hereby certify that under requirements of P.A. 74 Michigan P.A. of 1970, the corner points mentioned in lines 1 and 2 above were in conformance with regulations and rules therefore as required in the current manual of survey instructions of the United States Department of the interior, Bureau of Land Management or by a decree of a Court of Law and/or that the corner points mentioned in lines 3, 4 and 5 above were in conformance with the rules of the Michigan Board of Land Surveyors or by a Decree of a Court of Law; established, re-established, monumented, re-monumented, recovered, found as expressed below:

NOTE: Not more than 4 corners, all in the same town and range, may be recorded on this certificate.

A. Description of original monument and accessories and/or subsequent restoration:

G-4	1838	G.L.O. Notes	N. Brookfield	Set Post
	1937	Witness Map	K.C. Surveyor	Iron
	1983	L.C.R.C. #3371	J. Bueche	Set Iron
	1983	L.C.R.C. #3486	J. Bueche	Fnd. Iron / Set K.C. Monument
	1991	L.C.R.C. #5787	Exxel Engineering	K.C. Monument

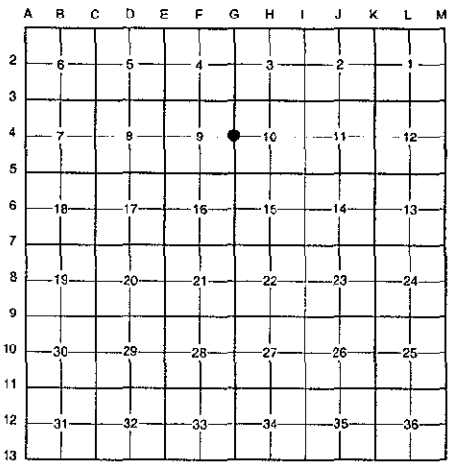

P.A. 345 1990 KENT COUNTY
PEER APPROVED 2/19/98
CHAIRMAN Tim J. Bueche

This corner was originally approved by the Kent County Remonumentation Peer Group and monumented by J. Bueche on 7/25/83 and was recorded per L.C.R.C. #3486.

B. Description of corner evidence found and/or method applied in restoring or reestablishing corner:

G-4 Found a Standard Kent County Monument 2' East of the C/L of Alden Nash (bit.) running North and South, 3' North of the C/L of Finn (gravel) running West, on line of a tree row and fence line running East per L.C.R.C.'s #3486 and #5787 as set by J. Bueche in place of an iron he found which checked L.C.R.C. #3371 and the K.C. Surveyor's records.

L.C.R.C. #3486

L.C.R.C. #5787

P.K. nail & tag in N. side of fence post N 90° E 33.28'
NE cor. Conc. Slab (MBT Box) S 55° W 59.42'
P.K. nail in S.W.'ly side power pole S 40° E 93.22'
S edge of sign N 75° W 70.11'
Top C/L of steel fence post S 50° E 40.00'


Nail & remon tag in S side of most S'ly 12" Ash in clump S85°E 69.59'(m. 69.49')
"X" in top center of large boulder N 12°W 101.18' (m. 101.20')
Nail & remon tag in side of P.Pole S 32°E 93.13' (m. 93.15')
NE cor conc. Slab of MBT box S 60°W 59.46' (m. 59.50')

The selected location is accepted by me and is generally accepted by professional surveyors as the best available evidence of the position of the original corner.

C. Description of monument for corner and accessories established to perpetuate locating the position of the corner:

G-4 Standard Kent County Monument

Nail & K.C. remon. tag on S side most S'ly 12" Ash in clump S 85° E 64.99'
Nail & K.C. remon. tag on SE side P. pole S 32° E 93.15'
Nail & K.C. remon. tag on NW side P. pole N 25° E 159.60'
NE cor. conc. slab to met. box S 60° W 59.50'
"X" cut in top center of large boulder N 12° W 101.20'
C/L bit. road running N-S, West 2.0'
C/L gravel road running W, South 3.0'
On fence line and tree row running E

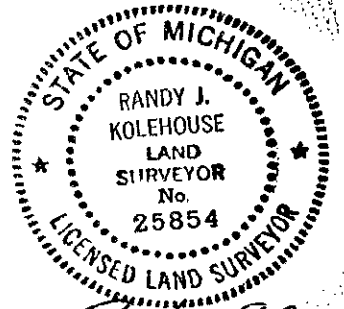

Signed by Randy J. Kolehouse
EARTH TECH

Date 9-7-98

Surveyor's Michigan License No. 25854