

\$7.00
\$2.00

MAR 08 1999

SECTION

LAND CORNER RECORDATION CERTIFICATE
Filing Requirement of Act 74, Mich. P.A. 1970
KENT COUNTY REMONUMENTATION

STATE OF MICHIGAN
COUNTY OF KENT
RECEIVED FOR RECORD
98 OCT 23 AM 9:57
REG. OF DEEDS
Lucy Spauld

10774

Register of Deeds Stamp & File Number

For corners in Kent (County) Located in: Vergennes Township Corner Code #

1. Public Land Survey	T <u>7N</u> R <u>9W</u>	<u>G-5</u>
	T _____ R _____	_____
	T _____ R _____	_____
	T _____ R _____	_____
2. Property Controlling in Section	S _____ T _____ R _____	_____
	S _____ T _____ R _____	_____
3. Miscellaneous Property in Sec.	S _____ T _____ R _____	_____
	S _____ T _____ R _____	_____


4. Lot No. _____, Recorded Plat _____
5. Private Claims _____

I, Randy Kolehouse, in a field survey on December 26 19 98, do hereby certify that under requirements of P.A. 74 Michigan P.A. of 1970, the corner points mentioned in lines 1 and 2 above were in conformance with regulations and rules therefore as required in the current manual of survey instructions of the United States Department of the interior, Bureau of Land Management or by a decree of a Court of Law and/or that the corner points mentioned in lines 3, 4 and 5 above were in conformance with the rules of the Michigan Board of Land Surveyors or by a Decree of a Court of Law; established, re-established, monumented, re-monumented, recovered, found as expressed below:

NOTE: Not more than 4 corners, all in the same town and range, may be recorded on this certificate.

A. Description of original monument and accessories and/or subsequent restoration:

G-5	1838	G.L.O. Notes	N. Brookfield	Set Post
	1939	Witness Map	K.C. Surveyor	Concrete Monument
	1973	L.C.R.C. #400	Williams & Works	"T" Iron
	1981	L.C.R.C. #1940	Jonker Land Survey	Fnd. RR Spike / Set K.C. Monument
	1991	L.C.R.C. #5788	Exxel Engineering	K.C. Monument

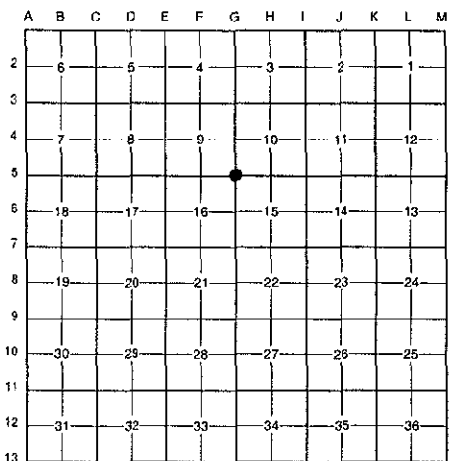

P.A. 345 1990 KENT COUNTY
PEER APPROVED 2/19/98
CHAIRMAN *Randy Kolehouse*

This corner was originally approved by the Kent County Remonumentation Peer Group and monumented by Rob Jonker on 8/7/81 and was recorded per L.C.R.C. #1940.

B. Description of corner evidence found and/or method applied in restoring or reestablishing corner:

G-5 Found a Standard Kent County Monument 3.5' West of the C/L of Alden Nash (bit.) running North and South and 5' North of the C/L of 2 Mile Road (gravel) running West per L.C.R.C.'s #1940 and #5788 as set by Rob Jonker in place of a RR spike he found at grade over a concrete monument 3'8" below grade which checked L.C.R.C. #400 and the K.C. Surveyor's records.

L.C.R.C. #1940

L.C.R.C. #5788

Remon. tag on N. side p.pole S89°E 46.70'

Nail & remon tag in SW side 12" Maple clump 39.05' (m. 39.02')


Remon. tag on SW side 8" maple clump S43°E 38.94'

The selected location is accepted by me and is generally accepted by professional surveyors as the best available evidence of the position of the original corner.

C. Description of monument for corner and accessories established to perpetuate locating the position of the corner:

G-5 Standard Kent County Monument

- Nail & K.C. remon. tag on SW side 12" Maple clump S 43° E 39.02'
- Nail & K.C. remon. tag on SW side 24" Maple 5' abv. gnd. N 36° W 72.13'
- Nail & K.C. remon. tag on SE side 12" Maple 6' abv. gnd. S 70° W 88.19'
- Nail & K.C. remon. tag on N side cut off P. pole S 89° E 46.71'
- C/L bit. road running N-S, East 3.5'
- C/L gravel road running W, South 5.0'

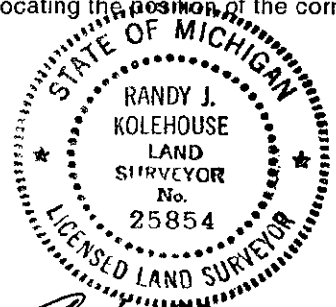

Signed by *Randy J. Kolehouse* Date 9-1-98
EARTH TECH

Surveyor's Michigan License No. 25854