

\$7.00
\$2.00

MAR 08 1999

SECTION

LAND CORNER RECORDATION CERTIFICATE
Filing Requirement of Act 74, Mich. P.A. 1970
KENT COUNTY REMONUMENTATION

STATE OF MICHIGAN
COUNTY OF KENT
RECEIVED FOR RECORD
38 OCT 23 AM 9:57
REG. OF DEEDS
W. J. Colehouse


For corners in

Kent (County)	Located in: Vergennes Township	Corner Code #
1. Public Land Survey	T <u>7N</u> R <u>9W</u>	<u>G-7</u>
	T _____ R _____	_____
	T _____ R _____	_____
	T _____ R _____	_____
2. Property Controlling in Section	S _____ T _____ R _____	_____
	S _____ T _____ R _____	_____
3. Miscellaneous Property in Sec.	S _____ T _____ R _____	_____
	S _____ T _____ R _____	_____

10776

Register of Deeds Stamp & File Number

- 4. Lot No. _____, Recorded Plat _____
- 5. Private Claims _____

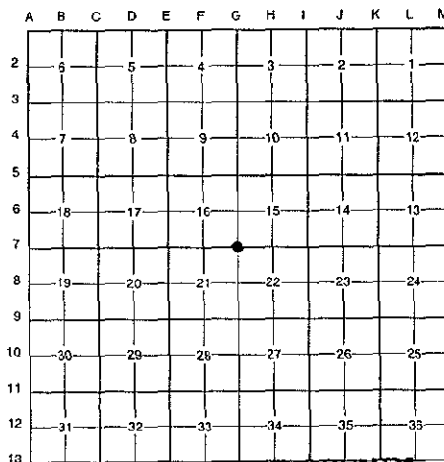

I, Randy Kolehouse, in a field survey on December 30 19 98, do hereby certify that under requirements of P.A. 74 Michigan P.A. of 1970, the corner points mentioned in lines 1 and 2 above were in conformance with regulations and rules therefore as required in the current manual of survey instructions of the United States Department of the interior; Bureau of Land Management or by a decree of a Court of Law and/or that the corner points mentioned in lines 3, 4 and 5 above were in conformance with the rules of the Michigan Board of Land Surveyors or by a Decree of a Court of Law; established, re-established, monumented, re-monumented, recovered, found as expressed below:

NOTE: Not more than 4 corners, all in the same town and range, may be recorded on this certificate.

A. Description of original monument and accessories and/or subsequent restoration:

G-7	1838	G.L.O. Notes	N. Brookfield	Set Post
	1937	Witness Map	K.C. Surveyor	Iron on Leaded Stone
	1983	L.C.R.C. #3292	Giazza & Associates	N/A
	1983	L.C.R.C. #3454	Williams & Works	Fnd. "T" Iron Above 3/4" Iron / Set K.C. Monument
	1991	L.C.R.C. #5790	Exxel Engineering	K.C. Monument

P.A. 345 1990 KENT COUNTY

PEER APPROVED 2/19/98
CHAIRMAN [Signature]

This corner was originally approved by the Kent County Remonumentation Peer Group and monumented by Williams & Works on 7/7/83 and was recorded per L.C.R.C. #3454.

B. Description of corner evidence found and/or method applied in restoring or reestablishing corner:

G-7 Found a Standard Kent County Monument 5' ± North of the C/L intersection of Alden Nash (bit.) running North and South and McPherson Street (gravel) running East and West per L.C.R.C.'s #3454 and #5790 as set by Williams & Works in place of a "T" iron they found over a 3/4" iron which checked L.C.R.C. #3292 and the K.C. Surveyor's records.

L.C.R.C. #3454

L.C.R.C. #5790

- Nail & KC. Remon.tag in W.side Power Pole N.30°E. 71.83'
- Nail & KC. Remon.tag in E.side 16" Oak N.30°W. 57.01'
- Nail & KC. Remon.tag in E.side 20" Oak S.20°W. 89.32'
- Nail & KC. Remon.tag in N.side 24" Wild Cherry S.65°E. 63.88'


- Nail & remon tag in N side 24" W. Cherry S 64° E 63.83' (m. 64.11')
- Nail & remon tag in NE side 18" Oak N 25° W 57.16' (m. 57.12')
- Nail & remon tag in W side P. Pole N 34° E 71.84' (m. 71.90')
- Nail & remon tag in E side 24" Oak S 23° W 89.33' (m. 89.32')

The selected location is accepted by me and is generally accepted by professional surveyors as the best available evidence of the position of the original corner.

C. Description of monument for corner and accessories established to perpetuate locating the position of the corner:

G-7 Standard Kent County Monument

- Nail & K.C. remon. tag on N side 24" W. Cherry S 64° E 64.11'
- Nail & K.C. remon. tag on NE side 18" Oak N 25° W 57.12'
- Nail & K.C. remon. tag on W side P. pole N 34° E 71.90'
- Nail & K.C. remon. tag on E side 24" Oak S 23° W 89.32'
- On C/L bit. road running N-S
- C/L gravel road running E-W, South 5.0'

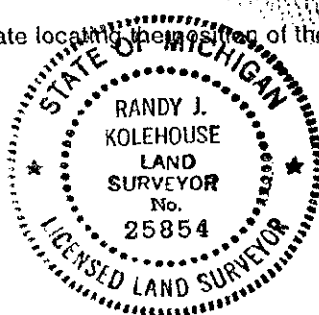

Signed by [Signature]

Date 9-1-98

EARTH TECH

Surveyor's Michigan License No. 25854