

MAR 08 1999

\$7.00
\$2.00

SECTION

LAND CORNER RECORDATION CERTIFICATE
Filing Requirement of Act 74, Mich. P.A. 1970
KENT COUNTY REMONUMENTATION

STATE OF MICHIGAN
COUNTY OF KENT
RECEIVED FOR RECORD
98 OCT 23 AM 9:57
REG. OF DEEDS
Lucy Bond

For corners in


Kent (County)	Located in:	Vergennes Township	Corner Code #
1. Public Land Survey	T <u>7N</u>	R <u>9W</u>	<u>G-8</u>
	T _____	R _____	_____
	T _____	R _____	_____
	T _____	R _____	_____
2. Property Controlling in Section	S _____	T _____	R _____
	S _____	T _____	R _____
3. Miscellaneous Property in Sec.	S _____	T _____	R _____
	S _____	T _____	R _____

10777

Register of Deeds Stamp & File Number

4. Lot No. _____, Recorded Plat _____
5. Private Claims _____

I, Randy Kolehouse, in a field survey on January 6 19 98, do hereby certify that under requirements of P.A. 74 Michigan P.A. of 1970, the corner points mentioned in lines 1 and 2 above were in conformance with regulations and rules therefore as required in the current manual of survey instructions of the United States Department of the Interior, Bureau of Land Management or by a decree of a Court of Law and/or that the corner points mentioned in lines 3, 4 and 5 above were in conformance with the rules of the Michigan Board of Land Surveyors or by a Decree of a Court of Law; established, re-established, monumented, re-monumented, recovered, found as expressed below:

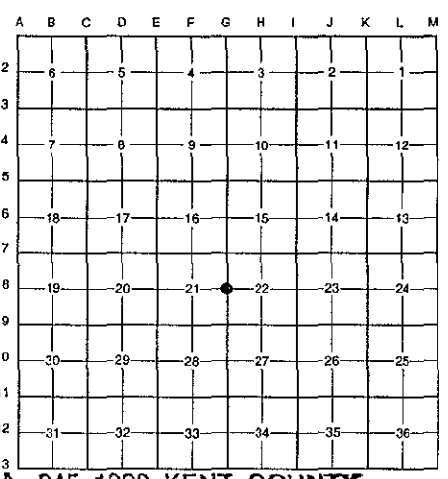

NOTE: Not more than 4 corners, all in the same town and range, may be recorded on this certificate.

A. Description of original monument and accessories and/or subsequent restoration:

G-8	1838	G.L.O. Notes	N. Brookfield	Set Post
	1963	Witness Map	K.C. Surveyor	1-1/4" Iron
	1971	L.C.R.C. #59	Williams & Works	1-1/4" Iron
	1981	L.C.R.C. #1942	Jonker Land Survey	Fnd. "T" Iron Inside of 1-1/2"x30" Pipe / Set K.C. Mon.
	1991	L.C.R.C. #5791	Exxel Engineering	K.C. Monument

P.A. 345 1990 KENT COUNTY
PEER APPROVED 2/19/98
CHAIRMAN [Signature]

This corner was originally approved by the Kent County Remonumentation Peer Group and monumented by Rob Jonker on 8/6/81 and was recorded per L.C.R.C. #1942.

B. Description of corner evidence found and/or method applied in restoring or reestablishing corner:

G-8 Found a Standard Kent County Monument 6' West of the C/L of Alden Nash (bit.) running North and South, on line of a tree row running East and West, per L.C.R.C.'s #1942 and #5791 as set by Rob Jonker in place of a "T" iron he found at grade inside a 1-1/2"x30" pipe 12" below grade which checked L.C.R.C. #59 and the K.C. Surveyor's records.

L.C.R.C. #1942

L.C.R.C. #5791


Remon. tag on N side 8" Hickory S88°W 34.63'
Remon. tag on SW side 15" Oak N38°W 47.92'
Remon. tag on N side 15" Oak S84°E 33.44'
Remon. tag on E side 16" Hickory S21°W 81.88'

Nail & remon tag in N side 10" Hickory West 34.59'
Nail & remon tag in SW side 16" Oak N 37°W 47.83' (m. 47.79')
Nail & remon tag in E side 18" Hickory S 22°W 81.80' (m. 81.84')

The selected location is accepted by me and is generally accepted by professional surveyors as the best available evidence of the position of the original corner.

C. Description of monument for corner and accessories established to perpetuate location of the corner:

G-8 Standard Kent County Monument
Nail & K.C. remon. tag on N side 10" Hickory West 34.59'
Nail & K.C. remon. tag on SW side 16" Oak N 37° W 47.79'
Nail & K.C. remon. tag on E side 18" Hickory S 22° W 81.84'
Nail & K.C. remon. tag on N side 15" Twin Oak S 84° E 33.33'
On C/L bit. road running N-S
On tree row running E-W

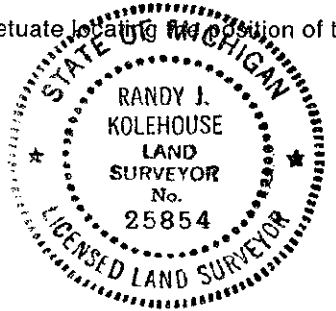

Signed by Randy J. Kolehouse
EARTH TECH

Date 9-1-98

Surveyor's Michigan License No. 25854