

MAR 08 1999

\$7.00
\$2.00

LAND CORNER RECORDATION CERTIFICATE
Filing Requirement of Act 74, Mich. P.A. 1970
KENT COUNTY REMONUMENTATION

SECTION

For corners in

Kent (County)	Located in:	Vergennes Township	Corner Code #
1. Public Land Survey	T <u>7N</u>	R <u>9W</u>	<u>G-9</u>
	T _____	R _____	_____
	T _____	R _____	_____
	T _____	R _____	_____
2. Property Controlling in Section	S _____	T _____	R _____
	S _____	T _____	R _____
3. Miscellaneous Property in Sec.	S _____	T _____	R _____
	S _____	T _____	R _____

REG. OF DEEDS

Lucy Sand

98 OCT 23 AM 9:57

STATE OF MICHIGAN
COUNTY OF KENT
RECEIVED FOR RECORD

10778
Register of Deeds Stamp & File Number

- 4. Lot No. _____, Recorded Plat _____
- 5. Private Claims _____

I, Randy Kolehouse, in a field survey on January 5 19 98, do hereby certify that under requirements of P.A. 74 Michigan P.A. of 1970, the corner points mentioned in lines 1 and 2 above were in conformance with regulations and rules therefore as required in the current manual of survey instructions of the United States Department of the Interior, Bureau of Land Management or by a decree of a Court of Law and/or that the corner points mentioned in lines 3, 4 and 5 above were in conformance with the rules of the Michigan Board of Land Surveyors or by a Decree of a Court of Law; established, re-established, monumented, re-monumented, recovered, found as expressed below:

NOTE: Not more than 4 corners, all in the same town and range, may be recorded on this certificate.


A. Description of original monument and accessories and/or subsequent restoration:

G-9	1838	G.L.O. Notes	N. Brookfield	Set Post
	1963	Witness Map	K.C. Surveyor	1/2" Iron
	1972	L.C.R.C. #440	Medema, Van Kooten & Assoc.	1-1/4" Iron
	1981	L.C.R.C. #1943	Jonker Land Survey	1" Rd. Iron / Set K.C. Monument
	1991	L.C.R.C. #5792	Exxel Engineering	K.C. Monument

P.A. 345 1990 KENT COUNTY

PEER APPROVED 2/19/98

CHAIRMAN Harry Huber

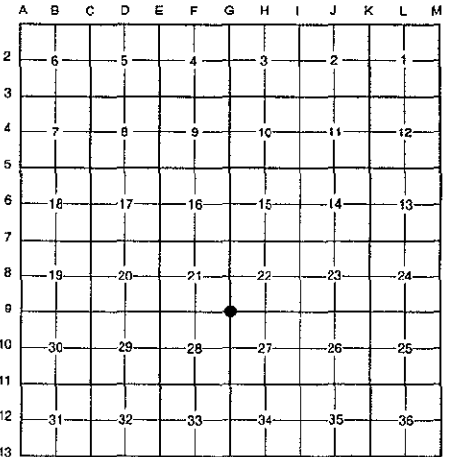

This corner was originally approved by the Kent County Remonumentation Peer Group and monumented by Rob Jonker on 8/5/81 and was recorded per L.C.R.C. #1943.

B. Description of corner evidence found and/or method applied in restoring or reestablishing corner:

G-9 Found a Standard Kent County Monument on the C/L of Bailey Road (bit.) running East and West, 3.5' East of the C/L of Alden Nash (bit.) running North, and 11' ± West of the C/L of Alden Nash (gravel) running South per L.C.R.C.'s #1943 and #5792 as set by Rob Jonker in place of a 1" round iron he found which checked L.C.R.C. #440 and the K.C. Surveyor's records.

L.C.R.C. #1943

L.C.R.C. #5792

Remon. tag on W side 11" Oak S23°W 89.43'
Remon. tag on NE side Wooden sign post N55°W 70.08'
Remon. tag on SE side 9" Pine N31°E 98.95'

Nail & remon tag in NW side 13" Oak S W 89.39' (m. 89.40')
Nail & remon tag in SE side 12" Pine N 35°E 98.95' (m. 98.97')

The selected location is accepted by me and is generally accepted by professional surveyors as the best available evidence of the position of the original corner.

C. Description of monument for corner and accessories established to perpetuate locating the position of the corner:

G-9 Standard Kent County Monument

- Nail & K.C. remon. tag on NW side 15" Oak S 25° W 89.40'
- Nail & K.C. remon. tag on SE side 12" Pine N 35° E 98.97'
- Nail & K.C. remon. tag on NE side Wooden Sign Post N 55° W 70.19'
- Nail & K.C. remon. tag on W side 10" Pine S 26° E 60.81'
- On C/L bit. road running E-W
- C/L bit. road running N, West 3.5'
- C/L gravel road running S, East 11.0' ±



Signed by *Randy J. Kolehouse* Date 9-1-98

EARTH TECH

Surveyor's Michigan License No. 25854