

SURVEY & REMONUMENTATION

MAY 22 2000

Seg 2

LAND CORNER RECORDATION CERTIFICATE
Filing Requirement of Act 74, Mich. P.A. 1970
KENT COUNTY REMONUMENTATION

For corners in **SECTION**

Kent (County)	Located in:	Vergennes Township	Corner Code #
1. Public Land Survey	T <u>7N</u>	R <u>9W</u>	<u>G-11</u>
	T _____	R _____	_____
	T _____	R _____	_____
	T _____	R _____	_____
2. Property Controlling in Section	S _____	T _____	R _____
	S _____	T _____	R _____
3. Miscellaneous Property in Sec.	S _____	T _____	R _____
	S _____	T _____	R _____

REG. OF DEEDS

[Handwritten Signature]


1999 DEC 30 AM 9:54
 REGISTERED FOR RECORD
 STATE OF MICHIGAN
 DEPARTMENT OF LAND & WATER

11694

Register of Deeds Stamp & File Number

4. Lot No. _____, Recorded Plat _____
 5. Private Claims _____

I, Randy Kolehouse, in a field survey on December 29 19 99, do hereby certify that under requirements of P.A. 74 Michigan P.A. of 1970, the corner points mentioned in lines 1 and 2 above were in conformance with regulations and rules therefore as required in the current manual of survey instructions of the United States Department of the interior, Bureau of Land Management or by a decree of a Court of Law and/or that the corner points mentioned in lines 3, 4 and 5 above were in conformance with the rules of the Michigan Board of Land Surveyors or by a Decree of a Court of Law; established, re-established, monumented, re-monumented, recovered, found as expressed below:

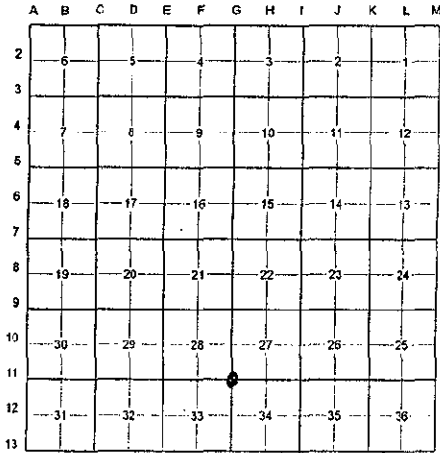

NOTE: Not more than 4 corners, all in the same town and range, may be recorded on this certificate.

A. Description of original monument and accessories and/or subsequent restoration:

G-11	1838	G.L.O. Notes	N. Brookfield	Set Post
	1946	Witness Map	K.C. Surveyor	1-1/2" Iron in Box
	1984	L.C.R.C. #3889	R. Kolehouse	Fnd. 1-1/2" Iron in Mon. Box / Set K.C. Mon. in Mon. Box
	1991	L.C.R.C. #5794	R. Unema	K.C. Monument in Mon. Box Encased in Conc.
	1998	L.C.R.C. #10942	Earth Tech	K.C. Monument in Mon. Box Encased in Conc.

This corner was originally approved by the Kent County Remonumentation Peer Group and monumented by Randy Kolehouse on 8/18/84 and was recorded per L.C.R.C. #3889. This corner was remonumented on 1/7/98 by Earth Tech and recorded per L.C.R.C. #10942.

B. Description of corner evidence found and/or method applied in restoring or reestablishing corner:

G-11 Found a Standard Kent County Monument per L.C.R.C. #10942 witnesses as set by Earth Tech.

L.C.R.C. #10942

- Nail & K.C. remon. tag on SW side 5" Oak S 55° E 98.02'
- Nail & K.C. remon. tag on SE side 12" Oak S 77° W 173.77'
- Nail & K.C. remon. tag on E side P. pole N 48° W 50.13'
- Nail & K.C. remon. tag on E side 6" Pine N 30° E 89.45'
- C/L of bit. road running E-W, South 1.0'
- C/L of bit. road running E-W, West 1.0'


P.A. 345 1999 KENT COUNTY
 PEER APPROVED 9/24/98
 CHAIRMAN [Signature]

The selected location is accepted by me and is generally accepted by professional surveyors as the best available evidence of the position of the original corner.

C. Description of monument for corner and accessories established to perpetuate locating the position of the corner:

G-11 Reset a Standard Kent County Monument - Also Set a Monument Box

- Nail & K.C. remon. tag on SW side 5" Oak S 55° E 98.02'
- Nail & K.C. remon. tag on SE side 12" Oak S 77° W 173.77'
- Nail & K.C. remon. tag on E side P. pole N 48° W 50.13'
- Nail & K.C. remon. tag on E side 6" Pine N 30° E 89.45'
- C/L of bit. road running E-W, South 1.0'
- C/L of bit. road running E-W, West 1.0'

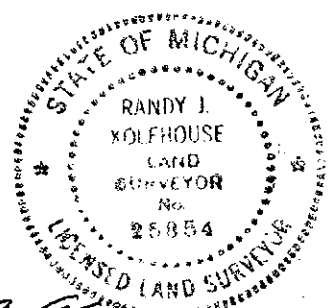

Signed by [Signature]
 WILLIAMS & WORKS

Date 12-29-99

Surveyor's Michigan License No. 25854