

\$7.00  
\$2.00

**SURVEY & REMONUMENTATION**

MAR 08 1999

**LAND CORNER RECORDATION CERTIFICATE**  
Filing Requirement of Act 74, Mich. P.A. 1970  
KENT COUNTY REMONUMENTATION

STATE OF MICHIGAN  
COUNTY OF KENT  
RECEIVED FOR RECORD  
98 OCT 23 AM 9:57  
REG. OF DEEDS  
*W. J. Standa*

For corners in

**SECTION**

Kent (County)	Located in: Vergennes Township	Corner Code #
1. Public Land Survey	T <u>7N</u> R <u>9W</u>	<u>H-3</u>
	T _____ R _____	_____
	T _____ R _____	_____
	T _____ R _____	_____
2. Property Controlling in Section	S _____ T _____ R _____	_____
	S _____ T _____ R _____	_____
3. Miscellaneous Property in Sec.	S _____ T _____ R _____	_____
	S _____ T _____ R _____	_____

**10782**

Register of Deeds Stamp & File Number

- 4. Lot No. \_\_\_\_\_, Recorded Plat \_\_\_\_\_
- 5. Private Claims \_\_\_\_\_


I, Randy Kolehouse, in a field survey on January 23 19 98, do hereby certify that under requirements of P.A. 74 Michigan P.A. of 1970, the corner points mentioned in lines 1 and 2 above were in conformance with regulations and rules therefore as required in the current manual of survey instructions of the United States Department of the interior, Bureau of Land Management or by a decree of a Court of Law and/or that the corner points mentioned in lines 3, 4 and 5 above were in conformance with the rules of the Michigan Board of Land Surveyors or by a Decree of a Court of Law; established, re-established, monumented, re-monumented, recovered, found as expressed below:

**NOTE: Not more than 4 corners, all in the same town and range, may be recorded on this certificate.**

**A. Description of original monument and accessories and/or subsequent restoration:**

H-3	1838	G.L.O. Notes	N. Brookfield	Set Post
	1902	Survey	Williams & Works	N/A
	1908	Survey	Williams & Works	Iron & Ring of Stones
	N/A	Witness Map	K.C. Surveyor	1" Iron
	1983	L.C.R.C. #3542	T. Chettleburgh	End. Steel Fence Post & Stones / Set K.C. Monument
	1995	L.C.R.C. #8224	William Byl	K.C. Monument

P.A. 345 1990 KENT COUNTY  
PEER APPROVED 2/19/98  
CHAIRMAN *Harry Huber*

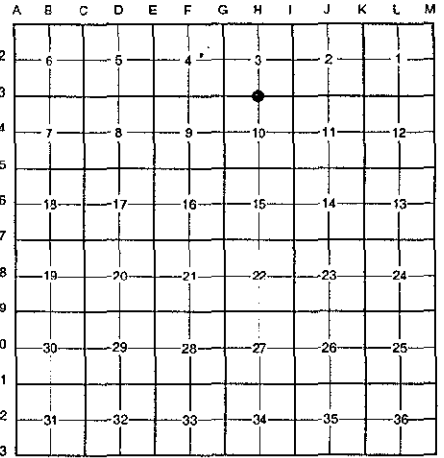

This corner was originally approved by the Kent County Remonumentation Peer Group and monumented by T. Chettleburgh on 8/22/83 and was recorded per L.C.R.C. #3542.

**B. Description of corner evidence found and/or method applied in restoring or reestablishing corner:**

H-3 Found a Standard Kent County Monument 150' ± North of 3 Mile Road (gravel) running East and West, on line of a fence line running North and South, per L.C.R.C.'s #3542 and #8224 as set by T. Chettleburgh in place of a steel fence post he found above stones 2' to 3' deep which checked the Williams & Works' surveys and the K.C. Surveyor's records.

L.C.R.C. #3542

L.C.R.C. #8224

Nail in E side Tw 15" Oak North 67.02'  
Nail in NW side 10" Oak ENE 58.44'  
Nail in N side 20" Oak East 45.70'


Nail & KC Remon. tag E. side Tw. 18" Oak N05°E 67.02' (m. 67.03')  
Nail & KC Remon. tag SW side 12" Oak N70°E 58.50'  
Nail & KC Remon. tag N. side 20" Stump N90°E 45.70'  
Nail & KC Remon. tag W. side Tri. 10"-18" Elm N35°E 108.45' (m. 106.46')  
Nail & KC Remon. tag N. side 20" Pine N70°W 84.04' (m. 84.06')

The selected location is accepted by me and is generally accepted by professional surveyors as the best available evidence of the position of the original corner.

**C. Description of monument for corner and accessories established to perpetuate locating the position of the corner:**

H-3 Standard Kent County Monument

Nail & K.C. remon. tag on E side twin 18" Oak N 05° E 67.03'  
Nail & K.C. remon. tag on SW side 12" Oak N 70° E 58.50'  
Nail & K.C. remon. tag on N side 20" stump N 90° E 45.71'  
Nail & K.C. remon. tag on W side triple 10"-18" Elm N 35° E 108.46'  
Nail & K.C. remon. tag on N side 20" Pine N 70° W 84.06'  
On fence line running N-S

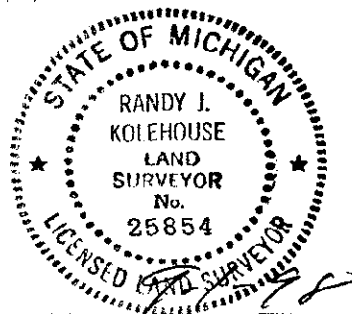

Signed by *Randy J. Kolehouse* Date \_\_\_\_\_

EARTH TECH

Surveyor's Michigan License No. 25854