

\$7.00
\$2.00

MAR 08 1999

LAND CORNER RECORDATION CERTIFICATE
Filing Requirement of Act 74, Mich. P.A. 1970
KENT COUNTY REMONUMENTATION

STATE OF MICHIGAN
COUNTY OF KENT
RECEIVED FOR RECORDS
98 OCT 23 AM 9:57
REG. OF DEEDS
Luci Sand


For corners in SECTION _____

Kent (County)	Located in: Vergennes Township	Corner Code #
1. Public Land Survey	T <u>7N</u> R <u>9W</u>	<u>H-5</u>
	T _____ R _____	_____
	T _____ R _____	_____
	T _____ R _____	_____
2. Property Controlling in Section	S _____ T _____ R _____	_____
	S _____ T _____ R _____	_____
3. Miscellaneous Property in Sec.	S _____ T _____ R _____	_____
	S _____ T _____ R _____	_____

4. Lot No. _____, Recorded Plat _____

5. Private Claims _____

10783
Register of Deeds Stamp & File Number

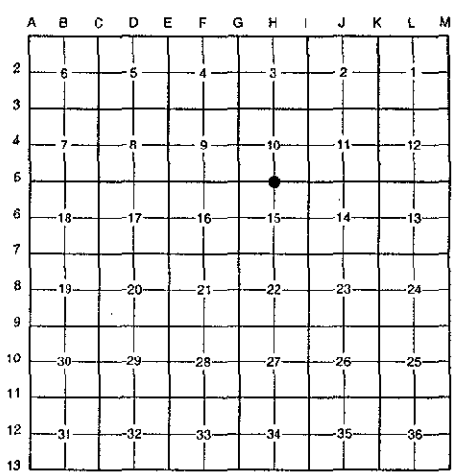

I, Randy Kolehouse, in a field survey on January 15 19 98, do hereby certify that under requirements of P.A. 74 Michigan P.A. of 1970, the corner points mentioned in lines 1 and 2 above were in conformance with regulations and rules therefore as required in the current manual of survey instructions of the United States Department of the interior, Bureau of Land Management or by a decree of a Court of Law and/or that the corner points mentioned in lines 3, 4 and 5 above were in conformance with the rules of the Michigan Board of Land Surveyors or by a Decree of a Court of Law; established, re-established, monumented, re-monumented, recovered, found as expressed below:

NOTE: Not more than 4 corners, all in the same town and range, may be recorded on this certificate.

- A. Description of original monument and accessories and/or subsequent restoration:
- | | | | | |
|-----|------|----------------|--------------------|------------------------------------|
| H-5 | 1838 | G.L.O. Notes | N. Brookfield | Set Post |
| | 1975 | L.C.R.C. #893 | Exxel Engineering | 3/4" Iron |
| | 1981 | L.C.R.C. #1945 | Jonker Land Survey | Fnd. 3/4" Iron / Set K.C. Monument |
| | 1995 | L.C.R.C. #8225 | William Byl | K.C. Monument |

P.A. 345 1990 KENT COUNTY
PEER APPROVED 2/19/98
CHAIRMAN [Signature]

This corner was originally approved by the Kent County Remonumentation Peer Group and monumented by Rob Jonker on 8/6/81 and was recorded per L.C.R.C. #1945.


- B. Description of corner evidence found and/or method applied in restoring or reestablishing corner:
- H-5 Found a Standard Kent County Monument on line of a downed fence running West, South and East and 300' ± West of railroad tracks running North and South per L.C.R.C.'s #1945 and #8225 as set by Rob Jonker in place of a 3/4" iron he found at a fence corner which checked L.C.R.C. #893.

L.C.R.C. #1945	L.C.R.C. #8225
Remon. tag on NW side 6" Elm N41°E 9.03'	Nail & KC Remon. tag NW side 10" Elm N41°E 9.13' (m. 9.12')
Remon. tag on NW side 9" Ash N35°W 26.71'	Nail & KC Remon. tag NW side 1 1/4" Ash N35°W 26.68' (m. 26.70')
Remon. tag on W side 16" Oak S19°E 18.09'	Nail & KC Remon. tag W. side 20" Oak S19°E 18.00' (m. 17.94')
Remon. tag on W side 14" Hickory S18°W 42.33'	Nail & KC Remon. tag W. side 18" Ash S18°W 42.38' (m. 42.41')
C/L Fence Corner to W,S,E is 0.5' South	C/L Fence Corner to W-S-E is 0.5' South

The selected location is accepted by me and is generally accepted by professional surveyors as the best available evidence of the position of the original corner.

- C. Description of monument for corner and accessories established to perpetuate locating the position of the corner:
- H-5 Standard Kent County Monument

- Nail & K.C. remon. tag on NW side 10" Elm N 41° E 9.12'
- Nail & K.C. remon. tag on NW side 14" Ash N 35° W 26.70'
- Nail & K.C. remon. tag on W side 20" Oak S 19° E 17.94'
- Nail & K.C. remon. tag on W side 18" Ash S 18° W 42.41'
- On fence line running S-E-W

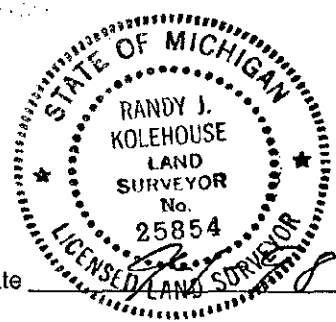

Signed by [Signature]
EARTH TECH
Surveyor's Michigan License No. 25854

Date _____