

\$7.00  
\$2.00

MAR 16 1999

LAND CORNER RECORDATION CERTIFICATE  
Filing Requirement of Act 74, Mich. P.A. 1970  
KENT COUNTY REMONUMENTATION

For corners in

SECTION

Kent (County)	Located in: Vergennes Township	Corner Code #
1. Public Land Survey	T <u>7N</u> R <u>9W</u>	<u>H-6</u>
	T _____ R _____	_____
	T _____ R _____	_____
	T _____ R _____	_____
2. Property Controlling in Section	S _____ T _____ R _____	_____
	S _____ T _____ R _____	_____
3. Miscellaneous Property in Sec.	S _____ T _____ R _____	_____
	S _____ T _____ R _____	_____

STATE OF MICHIGAN  
COUNTY OF KENT  
RECEIVED FOR RECORD

38 DEC 14 AM 8:00

REG. OF DEEDS


*Lucy Spauld*

11025

Register of Deeds Stamp & File Number

- 4. Lot No. \_\_\_\_\_, Recorded Plat \_\_\_\_\_
- 5. Private Claims \_\_\_\_\_

I, Randy Kolehouse, in a field survey on December 7 19 98, do hereby certify that under requirements of P.A. 74 Michigan P.A. of 1970, the corner points mentioned in lines 1 and 2 above were in conformance with regulations and rules therefore as required in the current manual of survey instructions of the United States Department of the interior, Bureau of Land Management or by a decree of a Court of Law and/or that the corner points mentioned in lines 3, 4 and 5 above were in conformance with the rules of the Michigan Board of Land Surveyors or by a Decree of a Court of Law; established, re-established, monumented, re-monumented, recovered, found as expressed below:

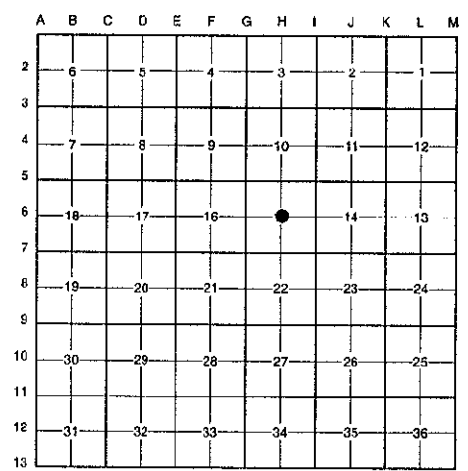

NOTE: Not more than 4 corners, all in the same town and range, may be recorded on this certificate.

A. Description of original monument and accessories and/or subsequent restoration:

H-6 This corner was not originally set by the G.L.O.

1944	Witness Map	K.C. Surveyor	Iron
N/A	Survey	Roosien Land Surveys	Rerod

P.A. 345 1990 KENT COUNTY  
PEER APPROVED 12/31/98  
CHAIRMAN *Harry Huber*

B. Description of corner evidence found and/or method applied in restoring or reestablishing corner:

H-6 Found a 1/2" iron 3' ± North of the C/L of Downes Road (gravel) running East and West, on line of a tree row running South, per the K.C. Surveyor's records and a survey by Roosien Land Surveys. Iron is 4.0' South and 3.0' West of the intersection of 1/4 lines. Accepted iron as Center of Section.

K.C. Witness Map


- 16" Maple NNW 22.40' (m. 20.48')
- 12" Oak ENE 41.75' (m. 41.86')
- 30" Oak ESE 47.15' (m. 48.00')

The selected location is accepted by me and is generally accepted by professional surveyors as the best available evidence of the position of the original corner.

C. Description of monument for corner and accessories established to perpetuate locating the position of the corner:

H-6 Replaced Iron with a Standard Kent County Monument

- Nail & K.C. remon. tag on S side 16" Maple N 60° W 26.48'
- Spike in S side 12" Oak stump (bad shape) N 60° E 41.86'
- Nail & K.C. remon. tag on NE side 40" Oak S 75° E 48.00'
- Nail & K.C. remon. tag on NE side 8" Maple N 82° E 81.83'
- Nail & K.C. remon. tag on W side P. pole N 35° E 57.90'
- Nail & K.C. remon. tag in W side P. pole due South 35.35'
- C/L of gravel road running E-W, South 3' ±
- On tree row running South

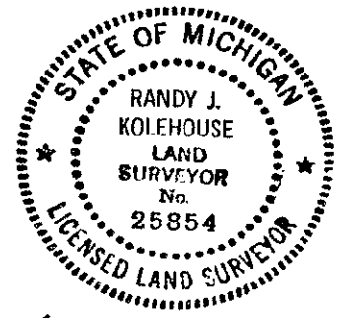

Signed by *Randy Kolehouse*  
EARTH TECH

Date 12/31/98

Surveyor's Michigan License No. 25854