

\$7.00
\$2.00

MAR 08 1999

LAND CORNER RECORDATION CERTIFICATE
Filing Requirement of Act 74, Mich. P.A. 1970
KENT COUNTY REMONUMENTATION

SECTION

For corners in

Kent (County)	Located in: Vergennes Township	Corner Code #
1. Public Land Survey	T <u>7N</u> R <u>9W</u>	<u>H-7</u>
	T _____ R _____	_____
	T _____ R _____	_____
	T _____ R _____	_____
2. Property Controlling in Section	S _____ T _____ R _____	_____
	S _____ T _____ R _____	_____
3. Miscellaneous Property in Sec.	S _____ T _____ R _____	_____
	S _____ T _____ R _____	_____

STATE OF MICHIGAN
COUNTY OF KENT
RECEIVED FOR RECORD

98 OCT 23 AM 9:57

REG. OF DEEDS
W. J. Bond

10784

Register of Deeds Stamp & File Number


- 4. Lot No. _____, Recorded Plat _____
- 5. Private Claims _____

I, Randy Kolehouse, in a field survey on December 29 19 97, do hereby certify that under requirements of P.A. 74 Michigan P.A. of 1970, the corner points mentioned in lines 1 and 2 above were in conformance with regulations and rules therefore as required in the current manual of survey instructions of the United States Department of the interior, Bureau of Land Management or by a decree of a Court of Law and/or that the corner points mentioned in lines 3, 4 and 5 above were in conformance with the rules of the Michigan Board of Land Surveyors or by a Decree of a Court of Law; established, re-established, monumented, re-monumented, recovered, found as expressed below:

NOTE: Not more than 4 corners, all in the same town and range, may be recorded on this certificate.

A. Description of original monument and accessories and/or subsequent restoration:

H-7	1838	G.L.O. Notes	N. Brookfield	Set Post
	1944	Witness Map	K.C. Surveyor	Monument
	1977	L.C.R.C. #1065	Williams & Works	1/2" Iron
	1981	L.C.R.C. #1946	Jonker Land Survey	Fnd. 1/2" Iron / Set K.C. Monument
	1995	L.C.R.C. #8226	William Byl	K.C. Monument

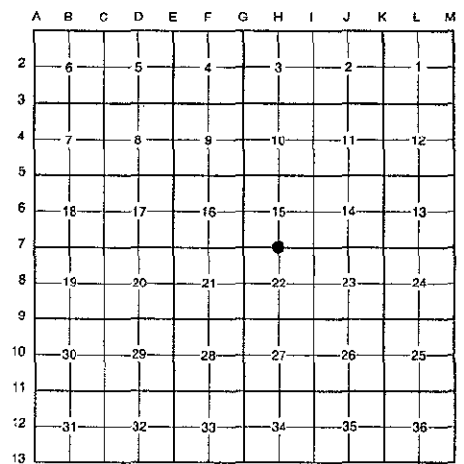

This corner was originally approved by the Kent County Remonumentation Peer Group and monumented by Rob Jonker on 8/6/81 and was recorded per L.C.R.C. #1946.

B. Description of corner evidence found and/or method applied in restoring or reestablishing corner:


H-7 Found a Standard Kent County Monument 2' North of the C/L of Mc Pherson Street (gravel), 25' ± West of RR tracks, on line of a tree row running North per L.C.R.C.'s #1946 and #8226 as set by Rob Jonker in place of a 1/2" iron he found inside of a 1" iron 1' below grade over a 4"x36" concrete monument 24" below grade which checked L.C.R.C. #1065 and the K.C. Surveyor's records.

L.C.R.C. #1946	L.C.R.C. #8226
C/L E-W gravel road 2' South In line with tree line North	Nail & KC Remon. tag W. side 6" Elm N00°E 55.48' (m. 55.43') Nail & KC Remon. tag N. side Guy Pole S85°W 113.30' (m. 113.35') C/L E-W grav. rd. 2' South In line with tree line North

The selected location is accepted by me and is generally accepted by professional surveyors as the best available evidence of the position of the original corner.

C. Description of monument for corner and accessories established to perpetuate locating the position of the corner:

- H-7 Standard Kent County Monument
- Nail & K.C. remon. tag on NE side Guy pole S 17° E 73.66'
 - Nail & K.C. remon. tag on S side P. pole N 76° E 94.50'
 - Nail & K.C. remon. tag on W side 6" Elm N 00° E 55.43'
 - Nail & K.C. remon. tag on N side Guy pole S 85° W 113.35'
 - C/L gravel road E-W, South 2.0' ±
 - On tree row running North

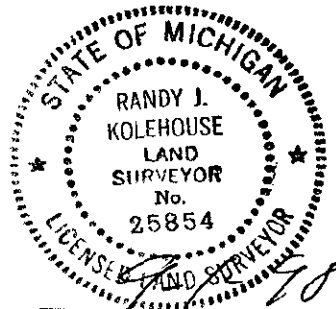

Signed by Randy J. Kolehouse Date _____
EARTH TECH

Surveyor's Michigan License No. 25854