

**SURVEY & REMONUMENTATION**

\$7.00  
\$2.00

DEC 08 1999

**LAND CORNER RECORDATION CERTIFICATE**  
Filing Requirement of Act 74, Mich. P.A. 1970  
KENT COUNTY REMONUMENTATION

SECTION

For corners in


Kent (County)	Located in: Vergennes Township	Corner Code #
1. Public Land Survey	T <u>7N</u> R <u>9W</u>	<u>H-9</u>
	T _____ R _____	_____
	T _____ R _____	_____
	T _____ R _____	_____
2. Property Controlling in Section	S _____ T _____ R _____	_____
	S _____ T _____ R _____	_____
3. Miscellaneous Property in Sec.	S _____ T _____ R _____	_____
	S _____ T _____ R _____	_____
4. Lot No. _____, Recorded Plat _____		
5. Private Claims _____		

STATE OF MICHIGAN  
COUNTY OF KENT  
RECEIVED FOR RECORD  
98 OCT 23 AM 9:57  
REG. OF DEEDS  
*Luigi Stank*

10785

Register of Deeds Stamp & File Number

I, Randy Kolehouse, in a field survey on January 12 1998, do hereby certify that under requirements of P.A. 74 Michigan P.A. of 1970, the corner points mentioned in lines 1 and 2 above were in conformance with regulations and rules therefore as required in the current manual of survey instructions of the United States Department of the Interior, Bureau of Land Management or by a decree of a Court of Law and/or that the corner points mentioned in lines 3, 4 and 5 above were in conformance with the rules of the Michigan Board of Land Surveyors or by a Decree of a Court of Law; established, re-established, monumented, re-monumented, recovered, found as expressed below:

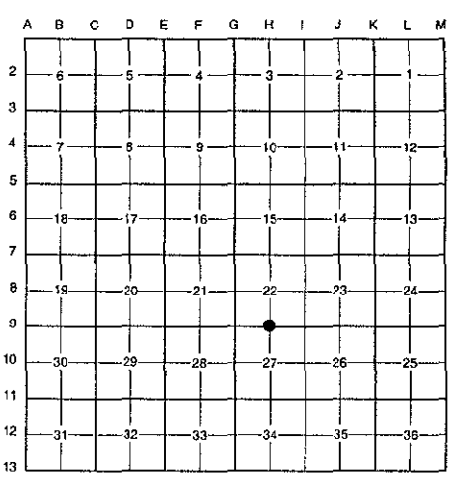

**NOTE: Not more than 4 corners, all in the same town and range, may be recorded on this certificate.**

**A. Description of original monument and accessories and/or subsequent restoration:**

H-9	1838	G.L.O. Notes	N. Brookfield	Set Post
	1963	Witness Map	K.C. Surveyor	Leaded Stone
	1972	L.C.R.C. #440	Medema, Van Kooten & Assoc.	Leaded Stone
	1981	L.C.R.C. #1947	Jonker Land Survey	Fnd. Leaded Stone / Set K.C. Monument
	1995	L.C.R.C. #8227	William Byl	K.C. Monument

\* P.A. 345 1990 KENT COUNTY

PEER APPROVED 2/19/98  
CHAIRMAN Randy Kolehouse

This corner was originally approved by the Kent Michigan Remonumentation Peer Group and monumented by Rob Jonker on 8/5/81 and was recorded per L.C.R.C. #1947.

**B. Description of corner evidence found and/or method applied in restoring or reestablishing corner:**

H-9 Found a Standard Kent County Monument 300' ± East of the C/L of Bailey Drive (bit.) running West and Southeast, on line of a tree row and downed fence running East and South, per L.C.R.C.'s #1947 and #8227 as set by Rob Jonker in place of a leaded stone he found which checked L.C.R.C. #440 and the K.C. Surveyor's records.

**L.C.R.C. #1947**

- Remon. tag on NE side 12" Oak N50°W 10.27'
- Remon. tag on SE side 12" tw.Oak N32°E 24.44'
- Remon. tag on S side 14" Oak N80°E 12.47'
- Remon. tag on SW side 14" Oak S30°W 16.68'
- C/L top 1 1/2" iron S72°E 1.13'

**L.C.R.C. #8227**


- Nail & KC Remon. tag NE side 18" Oak N50°W 10.28' (m. 10.26')
- Nail & KC Remon. tag SE side 28" Tw. Oak N32°E 24.44' (m. 24.60')
- Nail & KC Remon. tag S. side 20" Oak N80°E 12.55' (m. 12.62')
- Nail & KC Remon. tag SW side 20" Oak S30°W 16.78' (m. 16.80')
- C/L top 1 1/2" iron S72°E 1.13' (m. 1.15')

The selected location is accepted by me and is generally accepted by professional surveyors as the best available evidence of the position of the original corner.

**C. Description of monument for corner and accessories established to perpetuate locating the position of the corner:**

H-9 Standard Kent County Monument

- Nail & K.C. remon. tag on NE side 18" Oak N 50° W 10.26'
- Nail & K.C. remon. tag on SE side 28" Twin Oak N 32° E 24.60'
- Nail & K.C. remon. tag on S side 20" Oak N 80° E 12.62'
- Nail & K.C. remon. tag on SW side 20" Oak S 30° W 16.80'
- C/L top 1 1/2" iron S 72° E 1.15'
- C/L bit. road W-SE, West 300' ±
- On tree row and downed fence line running E-S

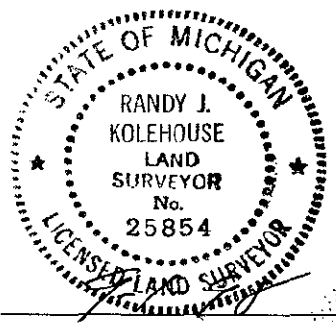

Signed by Randy J. Kolehouse Date \_\_\_\_\_  
EARTH TECH

Surveyor's Michigan License No. 25854