

MAR 08 1999

LAND CORNER RECORDATION CERTIFICATE
 Filing Requirement of Act 74, Mich. P.A. 1970
 KENT COUNTY REMONUMENTATION

STATE OF MICHIGAN
 COUNTY OF KENT
 RECEIVED FOR RECORD
 98 DEC 14 AM 8:00
 REG. OF DEEDS
Lucy Bond

For corners in

SECTION

Kent (County)	Located in:	Vergennes Township	Corner Code #
1. Public Land Survey	T <u>7N</u>	R <u>9W</u>	<u>H-10</u>
	T _____	R _____	_____
	T _____	R _____	_____
	T _____	R _____	_____
2. Property Controlling in Section	S _____	T _____	R _____
	S _____	T _____	R _____
3. Miscellaneous Property in Sec.	S _____	T _____	R _____
	S _____	T _____	R _____
4. Lot No. _____, Recorded Plat _____			
5. Private Claims _____			

10944

Register of Deeds Stamp & File Number

I, Randy Kolehouse, in a field survey on January 15 19 98, do hereby certify that under requirements of P.A. 74 Michigan P.A. of 1970, the corner points mentioned in lines 1 and 2 above were in conformance with regulations and rules therefore as required in the current manual of survey instructions of the United States Department of the Interior, Bureau of Land Management or by a decree of a Court of Law and/or that the corner points mentioned in lines 3, 4 and 5 above were in conformance with the rules of the Michigan Board of Land Surveyors or by a Decree of a Court of Law; established, re-established, monumented, re-monumented, recovered, found as expressed below:

NOTE: Not more than 4 corners, all in the same town and range, may be recorded on this certificate.

A. Description of original monument and accessories and/or subsequent restoration:

H-10 This corner was not originally set by the G.L.O.

Date	Survey Records	Williams & Works	Set Iron at Int. of 1/4 Lines
1957	Survey Records	Williams & Works	Set Iron at Int. of 1/4 Lines
1959	Witness Map	K.C. Surveyor	Iron
1972	L.C.R.C. #440	Medema, Van Kooten & Assoc.	"T" Iron
1973	Cert. Survey L. 16 P. 6	Medema, Van Kooten & Assoc.	"T" Iron

B. Description of corner evidence found and/or method applied in restoring or reestablishing corner:

H-10 Found a "T" iron as set by Williams & Works at the intersection of 1/4 lines in 1957 6.0' ± North of a tree row and a downed fence line running East and West and 300' ± West of the railroad tracks running North and South per L.C.R.C. #440 and Cert. Survey L. 16 P. 6. Iron is 0.5' East and 0.3' South of the intersection of 1/4 lines. Accepted iron as Center of Section.

K.C. Witness Map

L.C.R.C. #440

Face 8" Cherry South 5.45'
 Face 12" Oak ESE 14.37'
 Face 20" Oak WSW 42.8'
 E-W Fence South 6.0'

12" Wild Cherry S 5.95' (m. 6.54')
 15" Oak ESE 14.37' (m. 14.85')
 24" Oak SWS 42.80' (m. 43.24)
 East & West Fence S 6.0'

P.A. 345 1990 KENT COUNTY

PEER APPROVED 9/24/98


CHAIRMAN Randy Kolehouse

The selected location is accepted by me and is generally accepted by professional surveyors as the best available evidence of the position of the original corner.

C. Description of monument for corner and accessories established to perpetuate locating the position of the corner:

H-10 Replaced "T" Iron with a Standard Kent County Monument

- Nail & K.C. remon. tag on W side 8" Wild Cherry S 02° E 6.54'
- Nail & K.C. remon. tag on N side 18" Oak S 73° E 14.85'
- Nail & K.C. remon. tag on N side 30" Oak S 86° W 43.24'
- Nail & K.C. remon. tag on E side 6" Maple N 03° W 27.62'
- Nail & K.C. remon. tag on NE side 6" Maple N 42° W 6.57'
- Tree row and downed fence line running E-W, South 6'
- Railroad tracks running N-S, East 300' ±

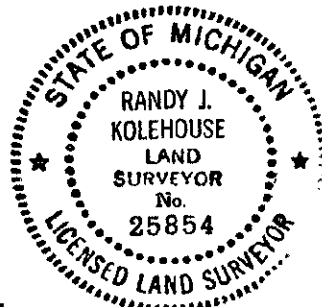

Signed by Randy J. Kolehouse

Date 10/18/98

EARTH TECH

Surveyor's Michigan License No. 25854

