

\$7.00  
\$2.00

DEC 08 1999

STATE OF MICHIGAN  
COUNTY OF KENT  
RECEIVED FOR RECORD  
98 OCT 23 AM 9:57  
REC. OF DEEDS  
*[Signature]*

SECTION LAND CORNER RECORDATION CERTIFICATE  
Filing Requirement of Act 74, Mich. P.A. 1970  
KENT COUNTY REMONUMENTATION

For corners in


Kent (County)	Located in: Vergennes Township	Corner Code #
1. Public Land Survey	T <u>7N</u> R <u>9W</u>	<u>H-11</u>
	T _____ R _____	_____
	T _____ R _____	_____
	T _____ R _____	_____
2. Property Controlling in Section	S _____ T _____ R _____	_____
	S _____ T _____ R _____	_____
3. Miscellaneous Property in Sec.	S _____ T _____ R _____	_____
	S _____ T _____ R _____	_____

10786

Register of Deeds Stamp & File Number

- 4. Lot No. \_\_\_\_\_, Recorded Plat \_\_\_\_\_
- 5. Private Claims \_\_\_\_\_

I, Randy Kolehouse, in a field survey on December 29 19 97, do hereby certify that under requirements of P.A. 74 Michigan P.A. of 1970, the corner points mentioned in lines 1 and 2 above were in conformance with regulations and rules therefore as required in the current manual of survey instructions of the United States Department of the interior, Bureau of Land Management or by a decree of a Court of Law and/or that the corner points mentioned in lines 3, 4 and 5 above were in conformance with the rules of the Michigan Board of Land Surveyors or by a Decree of a Court of Law; established, re-established, monumented, re-monumented, recovered, found as expressed below:

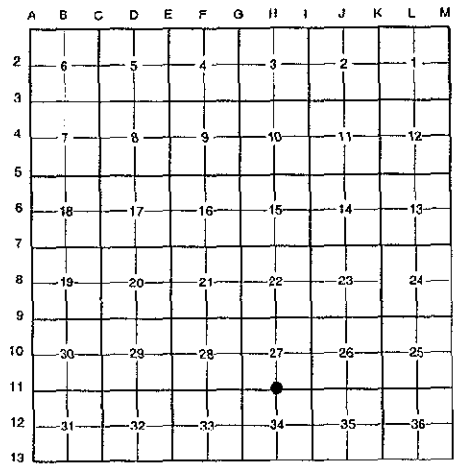

NOTE: Not more than 4 corners, all in the same town and range, may be recorded on this certificate.

A. Description of original monument and accessories and/or subsequent restoration:

H-11	1838	G.L.O. Notes	N. Brookfield	Set Post
	N/A	Witness Map	K.C. Surveyor	Iron in Box
	1973	L.C.R.C. #505	Williams & Works	1" Iron in Mon. Box
	1981	L.C.R.C. #1948	Jonker Land Survey	Fnd. 1" Iron in Mon. Box / Set K.C. Monument in Mon. Box
	1995	L.C.R.C. #8228	William Byl	K.C. Monument

P.A. 345 1990 KENT COUNTY  
PEER APPROVED 2/19/98  
CHAIRMAN [Signature]

This corner was originally approved by the Kent County Remonumentation Peer Group and monumented by Rob Jonker on 8/4/81 and was recorded per L.C.R.C. #1948.

B. Description of corner evidence found and/or method applied in restoring or reestablishing corner:  
H-11 Found a Standard Kent County Monument 1.0' North of the C/L of Vergennes Street (bit.) running East and West, on line of a tree row running South, per L.C.R.C.'s #1948 and #8228 as set by Rob Jonker in place of a 1" iron he found which checked L.C.R.C. #505 and the K.C. Surveyor's records.

L.C.R.C. #1948	L.C.R.C. #8228
Remon. tag on NE side 15" tw. Oak S51°E 46.90'	Nail & KC Remon. tag NE side 20" Tw. Oak S51°E 47.04' (m. 47.01')
Remon. tag on SE side 16" tw. Oak N57°E 44.02'	Nail & KC Remon. tag SE side 22" Tw. Oak N57°E 43.97' (m. 44.00')
Remon. tag on SW side 14" tw. Oak N15°W 27.41'	Nail & KC Remon. tag SW side 10" Tw. Oak N15°W 27.48' (m. 27.44')
C/L B.T. South 1'	Nail & KC Remon. tag E. side 14" Cedar S10°W 33.61' (m. 33.51')
	C/L B.T. South 1'

The selected location is accepted by me and is generally accepted by professional surveyors as the best available evidence of the position of the original corner.

C. Description of monument for corner and accessories established to perpetuate locating the position of the corner:  
H-11 Standard Kent County Monument  
Nail & K.C. remon. tag on NE side 20" twin Oak S 51° E 47.01'  
Nail & K.C. remon. tag on SE side 22" twin Oak N 57° E 44.00'  
Nail & K.C. remon. tag on SW side 20" twin Oak N 15° W 27.44'  
Nail & K.C. remon. tag on E side 14" Cedar S 10° W 33.51'  
C/L bit. road running E-W, South 1.0'  
On tree row running South



Signed by Randy J. Kolehouse Date 9-1-98

Surveyor's Michigan License No. 25854