

**SURVEY & REMONUMENTATION**

MAR 03 1998

KENT COUNTY REMONUMENTATION

STATE OF MICHIGAN  
COUNTY OF KENT  
RECEIVED FOR RECORD

97 APR 29 AM 8:28

**LAND CORNER RECORDATION CERTIFICATE**  
Filing Requirement of Act 74, Mich. P.A. 1970

**SECTION**

For corners in

<u>KENT COUNTY</u> (County)	Located In:	Corner Code #
1. Public Land Survey	T <u>7N</u> R <u>9W</u>	<u>H-13</u>
	T _____ R _____	_____
	T _____ R _____	_____
	T _____ R _____	_____
2. Property Controlling in Section	S _____ T _____ R _____	_____
	S _____ T _____ R _____	_____
3. Miscellaneous Property in Sec.	S _____ T _____ R _____	_____
	S _____ T _____ R _____	_____

*Eric J. Bond*  
REG. OF DEEDS

9904

Register of Deeds Stamp & File Number

4. Lot No. \_\_\_\_\_, Recorded Plat \_\_\_\_\_  
5. Private Claims \_\_\_\_\_

I, Kirk Breitels, in a field survey on Jan. 14, 1997 do hereby state that under requirements of P.A. 74, Michigan P.A. of 1970, the corner points mentioned in lines 1 and 2 above were in conformance with regulations and rules therefore as required in the current manual of survey instructions of the United States Department of the Interior, Bureau of Land Management or by a decree of a Court of Law and /or that the corner points mentioned in lines 3, 4 and 5 above were in conformance with the rules of the Michigan Board of Land Surveyors or by a Decree of a Court of Law; established, re-established, monumented, recovered, found as expressed below:

NOTE: Not more than 2 corners, all in the same town and range, may be recorded on this certificate.

	A	B	C	D	E	F	G	H	I	J	K	L	M
1													
2	6		5		4		3		2		1		
3													
4	7		8		9		10		11		12		
5													
6	18		17		16		15		14		13		
7													
8	19		20		21		22		23		24		
9													
10	30		29		28		27		26		25		
11													
12	31		32		33		34		35		36		
13													

A. Description of original monument and accessories and/or subsequent restoration:

H-13	GLO	Lyon	Set Post
1879-1973	Williams & Works		Leaded Stone
1967	Kent Co. Wit.		Leaded Stone
1985	LCRC #4206	Rosema	Set Kent County Monument
1995	LCRC #8229	Byl	Kent County Monument

The position of this corner was previously approved by the Kent County Remonumentation Peer Group, monumented by Maurice J. Rosema on 3/7/85 and was recorded per LCRC #4206

B. Description of corner evidence found and/or method applied in restoring or reestablishing corner:


H-13 Found standard Kent Co. Mon. (Harrison) per witnesses from above LCRC as set by Maurice J. Rosema in place of the Leaded Stone he found. Said Leaded Stone checks with Williams & Works information and Kent Co. Wit.

<u>LCRC #4206</u>	<u>LCRC #8229</u>		
Nail & tag 24" Oak	N67°E 17.93'	Nail & tag 28" Oak	N67°E 17.95'
Nail & tag 12" Oak	S85°W 4.64'	Nail & tag 18" Oak	S85°W 4.68'
Nail & tag 18" Oak	N15°W 18.41'	Nail & tag 24" Oak	N15°W 18.41'
Nail & tag 10" Elm	S75°E 32.24'	Nail & tag 16" Elm	S75°E 32.32'
H-1, T6N, R9W (KC Mon.) West	73.50'	H-1, T6N, R9W (KC Mon.)	S90°W 73.50'

The selected location is accepted by me and is generally accepted by professional surveyors as the best available evidence of the position of the original corner.

C. Description of monument for corner and accessories established to perpetuate locating the position of the corner:

H-13 Standard Kent County Monument	
Nail & KC Remon. tag SE side 28" Oak	N67°E 17.95'
Nail & KC Remon. tag S. side 18" Oak	S85°W 4.68'
Nail & KC Remon. tag SW side 24" Oak	N15°W 18.41'
Nail & KC Remon. tag N. side 16" Elm	S75°E 32.24'
H-1, T6N, R9W (Kent Co. Mon.)	S90°W 73.50'
Fence cor. (fences N-W-E) W. 6' & N. 2'	

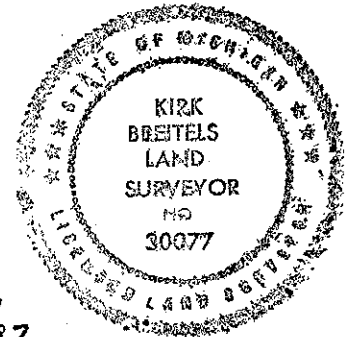

Signed by Kirk Breitels  
Surveyor's Michigan License No. 30077

Date 3/27/97

P.A. 345 1990 KENT COUNTY  
PEER APPROVED 3/27/97  
CHAIRMAN Harry Ruben