

SURVEY & REMONUMENTATION

\$7.00  
\$2.00

MAR 08 1999

LAND CORNER RECORDATION CERTIFICATE  
Filing Requirement of Act 74, Mich. P.A. 1970  
KENT COUNTY REMONUMENTATION

For corners in SECTION

Kent (County)	Located in: Vergennes Township	Corner Code #
1. Public Land Survey	T <u>7N</u> R <u>9W</u>	<u>I-1</u>
	T _____ R _____	_____
	T _____ R _____	_____
	T _____ R _____	_____
2. Property Controlling in Section	S _____ T _____ R _____	_____
	S _____ T _____ R _____	_____
3. Miscellaneous Property in Sec.	S _____ T _____ R _____	_____
	S _____ T _____ R _____	_____

STATE OF MICHIGAN  
COUNTY OF KENT  
RECEIVED FOR RECORD

38 OCT 23 AM 9:57

REG. OF DEEDS

*Lucy St. John*

10787

Register of Deeds Stamp & File Number

4. Lot No. \_\_\_\_\_, Recorded Plat \_\_\_\_\_  
5. Private Claims \_\_\_\_\_

I, Randy Kolehouse, in a field survey on January 7 19 98, do hereby certify that under requirements of P.A. 74 Michigan P.A. of 1970, the corner points mentioned in lines 1 and 2 above were in conformance with regulations and rules therefore as required in the current manual of survey instructions of the United States Department of the Interior, Bureau of Land Management or by a decree of a Court of Law and/or that the corner points mentioned in lines 3, 4 and 5 above were in conformance with the rules of the Michigan Board of Land Surveyors or by a Decree of a Court of Law; established, re-established, monumented, re-monumented, recovered, found as expressed below:

NOTE: Not more than 4 corners, all in the same town and range, may be recorded on this certificate.

A. Description of original monument and accessories and/or subsequent restoration:

I-1	1837	G.L.O. Notes	N. Brookfield	Set Post
	1944	Witness Map	K.C. Surveyor	3" Iron
	1986	L.C.R.C. #4357	R. Kolehouse	Fnd. 3/4" Iron in Mon. Box / Set K.C. Mon. in Mon. Box
	1991	L.C.R.C. #5917	William Byl	K.C. Monument in Mon. Box

Note: This corner is not common with I-13, T8N, R9W.

This corner was originally approved by the Kent County Remonumentation Peer Group and monumented by R. Kolehouse on 11/23/85 and was recorded per L.C.R.C. #4357.

B. Description of corner evidence found and/or method applied in restoring or reestablishing corner:

I-1 Found a Standard Kent County Monument in a monument box at the C/L intersection of Lincoln Lake Avenue (bit.) running North and South and 4 Mile Road (gravel) running East and West per L.C.R.C.'s #4357 and #5917 as set by R. Kolehouse in place of a 3/4" iron he found in a monument box which checked the K.C. Surveyor's records.

L.C.R.C. #4357  
West end (back) of conc. curb return N 65° W 66.05'  
West end (back) of conc. curb return S 65° W 65.85'  
NW cor C.B. S 25° E 64.08'  
NW cor C.B. S 65° E 70.43'  
SW cor C.B. N 65° E 69.90'

L.C.R.C. #5917  
West end (back) conc. curb return N65°W 66.08'  
West end (back) conc. curb return S65°W 65.85'  
NW cor. C.B. S25°E 64.06' (m. 64.08')  
NW cor. C.B. S65°E 70.47'  
SW cor. C.B. N65°E 69.93' (m. 69.90')  
Nail & KC Remon. tag N. side P. Pole N65°E 81.63' (m. 81.66')  
NW cor. Conc. blk. Slab to old school S50°E 137.22'  
KC Monument at SW cor. Sec. 35-8-9 S90°W 13.22' (m. 13.24')

The selected location is accepted by me and is generally accepted by professional surveyors as the best available evidence of the position of the original corner.


C. Description of monument for corner and accessories established to perpetuate locating the position of the corner:

I-1 Standard Kent County Monument in a Monument Box

Nail & K.C. remon. tag on N side P. pole N 65° E 81.66'  
Nail & K.C. remon. tag on SW side P. pole N 45° W 88.70'  
NW cor. C.B. S 25° E 64.08'  
NW cor. C.B. S 65° E 70.47'  
SW cor. C.B. N 65° E 69.90'  
NW cor. conc. blk. to old school S 50° E 137.22'

On C/L "X" of roads running E-W & N-S  
K.C. Mon., I-13, T8N, R9W, West 13.24'

Signed by Randy J. Kolehouse  
EARTH TECH  
Surveyor's Michigan License No. 25854

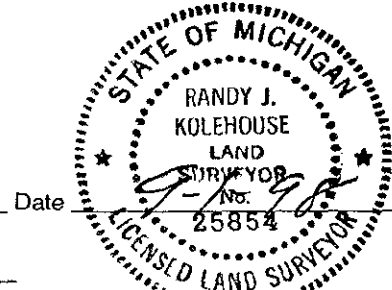

P.A. 345 1990 KENT COUNTY  
PEER APPROVED 2/11/98  
CHAIRMAN Larry Hubert

