

\$7.00
\$2.00

MAR 02 1999

LAND CORNER RECORDATION CERTIFICATE
Filing Requirement of Act 74, Mich. P.A. 1970
KENT COUNTY REMONUMENTATION

SECTION

For corners in


Kent (County)	Located in: Vergennes Township	Corner Code #
1. Public Land Survey	T <u>7N</u> R <u>9W</u>	<u>1-2</u>
	T _____ R _____	_____
	T _____ R _____	_____
	T _____ R _____	_____
2. Property Controlling in Section	S _____ T _____ R _____	_____
	S _____ T _____ R _____	_____
3. Miscellaneous Property in Sec.	S _____ T _____ R _____	_____
	S _____ T _____ R _____	_____

STATE OF MICHIGAN
COUNTY OF KENT
RECEIVED FOR RECORD
98 OCT 23 AM 9:57
REG. OF DEEDS
David Bond

10788

Register of Deeds Stamp & File Number

4. Lot No. _____, Recorded Plat _____
5. Private Claims _____

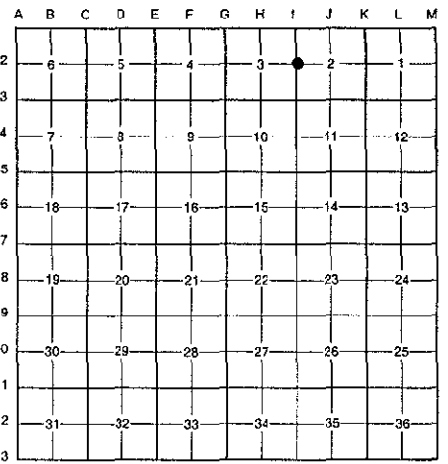

I, Randy Kolehouse, in a field survey on January 7 19 98, do hereby certify that under requirements of P.A. 74 Michigan P.A. of 1970, the corner points mentioned in lines 1 and 2 above were in conformance with regulations and rules therefore as required in the current manual of survey instructions of the United States Department of the interior, Bureau of Land Management or by a decree of a Court of Law and/or that the corner points mentioned in lines 3, 4 and 5 above were in conformance with the rules of the Michigan Board of Land Surveyors or by a Decree of a Court of Law; established, re-established, monumented, re-monumented, recovered, found as expressed below:

NOTE: Not more than 4 corners, all in the same town and range, may be recorded on this certificate.

A. Description of original monument and accessories and/or subsequent restoration:

I-2	1838	G.L.O. Notes	N. Brookfield	Set Post
	1944	Witness Map	K.C. Surveyor	3-1/2" Iron Pipe
	1986	L.C.R.C. #4473	T. Chettleburgh	Fnd. 5/8" Iron Pipe / Set K.C. Monument
	1995	L.C.R.C. #8230	William Byl	K.C. Monument

P.A. 345 1990 KENT COUNTY
PEER APPROVED 2/19/98

CHAIRMAN
Harry Huber

This corner was originally approved by the Kent County Remonumentation Peer Group and monumented by T. Chettleburgh on 4/1/86 and was recorded per L.C.R.C. #4473.

B. Description of corner evidence found and/or method applied in restoring or reestablishing corner:

I-2 Found a Standard Kent County Monument in a monument box at the C/L of Lincoln Lake Avenue (bit.) running North and South, on line of a tree row and fence line running West, per L.C.R.C.'s #4473 and #8230 as set by T. Chettleburgh in place of a 5/8" iron pipe he found in a monument box which checked the K.C. Surveyor's records.

L.C.R.C. #4473

L.C.R.C. #8230

Nail in South side Power Pole S78°E 49.14'	Nail & KC Remon. tag in S. side Power Pole S78°E 49.19'
Nail in SW side 9" White Pine S45°E 56.88'	Nail & KC Remon. tag in SW side 14" White Pine S45°E 56.96'
Nail in West side Power Pole S12°E 175.60'	Nail & KC Remon. tag in W. side Power Pole S12°E 175.60' (m. 175.50')
Nail in NW side 10" Elm S56°W 98.66'	Nail & KC Remon. tag in NW side 14" Elm S56°W 98.66' (m. 98.61')
Nail in North side 14" Ash N85°W 80.98'	Nail & KKC Remon. tag in W. side 18" Ash N85°W 80.98' (m. 81.01')

The selected location is accepted by me and is generally accepted by professional surveyors as the best available evidence of the position of the original corner.

C. Description of monument for corner and accessories established to perpetuate locating the position of the corner:

I-2 Standard Kent County Monument in a Monument Box
Nail & K.C. remon. tag on S side P. pole S 78° E 49.19'
Nail & K.C. remon. tag on SW side 14" White Pine S 45° E 56.96'
Nail & K.C. remon. tag on W side P. pole S 12° E 175.50'
Nail & K.C. remon. tag on NW side 14" Elm S 56° W 98.61'
Nail & K.C. remon. tag on N side 18" Ash N 85° W 81.01'
On C/L bit. road running N-S
On tree row and fence line running West



Signed by *Randy J. Kolehouse* Date _____
EARTH TECH

Surveyor's Michigan License No. 25854