

\$7.00
\$2.00

EAR 08 1999

LAND CORNER RECORDATION CERTIFICATE
Filing Requirement of Act 74, Mich. P.A. 1970
KENT COUNTY REMONUMENTATION

SECTION

For corners in

Kent (County)	Located in:	Vergennes Township	Corner Code #
1. Public Land Survey	T <u>7N</u>	R <u>9W</u>	<u>I-3</u>
	T _____	R _____	_____
	T _____	R _____	_____
	T _____	R _____	_____
2. Property Controlling in Section	S _____	T _____	R _____
	S _____	T _____	R _____
3. Miscellaneous Property in Sec.	S _____	T _____	R _____
	S _____	T _____	R _____


STATE OF MICHIGAN
COUNTY OF KENT
RECEIVED FOR RECORD
98 OCT 23 AM 9:57
REG. OF DEEDS
Lucy Land

10789

Register of Deeds Stamp & File Number

4. Lot No. _____, Recorded Plat _____
5. Private Claims _____

I, Randy Kolehouse, in a field survey on January 7 19 98, do hereby certify that under requirements of P.A. 74 Michigan P.A. of 1970, the corner points mentioned in lines 1 and 2 above were in conformance with regulations and rules therefore as required in the current manual of survey instructions of the United States Department of the interior, Bureau of Land Management or by a decree of a Court of Law and/or that the corner points mentioned in lines 3, 4 and 5 above were in conformance with the rules of the Michigan Board of Land Surveyors or by a Decree of a Court of Law; established, re-established, monumented, re-monumented, recovered, found as expressed below:

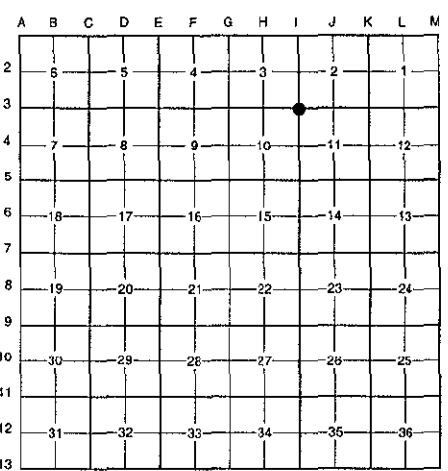

NOTE: Not more than 4 corners, all in the same town and range, may be recorded on this certificate.

A. Description of original monument and accessories and/or subsequent restoration:

I-3	1838	G.L.O. Notes	N. Brookfield	Set Post
	1902-74	N/A	Williams & Works	Wagon Skein - Iron - Monument Box
	1954	Witness Map	K.C. Surveyor	1" Iron
	1983	L.C.R.C. #3541	T. Chettleburgh	Fnd. Iron Pipe in Mon. Box / Set K.C. Monument
	1995	L.C.R.C. #8231	William Byl	K.C. Monument

This corner was originally approved by the Kent County Remonumentation Peer Group and monumented by T. Chettleburgh on 8/9/83 and was recorded per L.C.R.C. #3541.

B. Description of corner evidence found and/or method applied in restoring or reestablishing corner:

I-3 Found a Standard Kent County Monument in a monument box at the C/L intersection of Lincoln Lake Avenue (bit.) running North and South and 3 Mile Road (gravel to West) per L.C.R.C.'s #3541 and #8231 as set by T. Chettleburgh in place of an iron pipe he found in a monument box which checked the K.C. Surveyor's records.

L.C.R.C. #3541

L.C.R.C. #8231


Center of steel fence post SW corner Cemetery NNE 126.81'	Center of steel fence post SW corner of Cemetery N20°E 126.69' (m. 126.81')
SW corner Church foundation NE 117.47'	SW corner of Church foundation N45°E 117.47'
Nail in NE side Power Pole SE 103.05'	Nail & KC Remon. tag in NE side Power Pole S30°E 103.09'
Nail in NE side Power Pole NW 84.55'	Nail & KC Remon. tag in NE side Power Pole N40°W 84.52'

The selected location is accepted by me and is generally accepted by professional surveyors as the best available evidence of the position of the original corner.

C. Description of monument for corner and accessories established to perpetuate locating the position of the corner:

I-3 Standard Kent County Monument in a Monument Box

- Center of steel fence post SW cor. cemetery N 20° E 126.81'
- SW cor. church fndn. N 45° E 117.47'
- Nail & K.C. remon. tag on NE side P. pole S 30° E 103.09'
- Nail & K.C. remon. tag on NE side P. pole N 40° W 84.52'
- Nail & K.C. remon. tag on W side 14" White Pine N 21° E 128.18'
- Nail & K.C. remon. tag on N side 8" Box Elder 7' above gnd. S 75° W 134.50'
- On C/L "X" bit. roads N-S & E - gravel road W

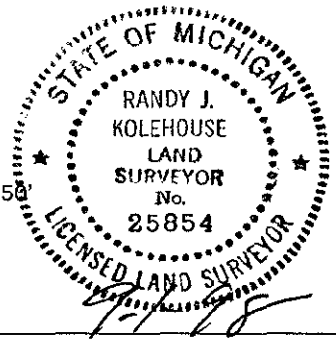

Signed by *Randy J. Kolehouse*
EARTH TECH

Date _____

Surveyor's Michigan License No. 25854

P.A. 345 1990 KENT COUNTY
PEER APPROVED 2/19/98
CHAIRMAN *Harold Huber*
FORM APPROVED BY MICHIGAN STATE BOARD OF LAND SURVEYORS, JAN. 28, 1971
REVISED MAY 14, 1975
REVISED JAN., 1983