

SURVEY & REMONUMENTATION

\$7.00
\$2.00

MAR 9 8 1999

LAND CORNER RECORDATION CERTIFICATE
Filing Requirement of Act 74, Mich. P.A. 1970
KENT COUNTY REMONUMENTATION

STATE OF MICHIGAN
COUNTY OF KENT
RECEIVED FOR RECORD
38 OCT 23 AM 9:57
REG. OF DEEDS
Lucy Board

For corners in


SECTION

Kent (County)	Located in: Vergennes Township	Corner Code #
1. Public Land Survey	T <u>7N</u> R <u>9W</u>	<u>1-4</u>
	T _____ R _____	_____
	T _____ R _____	_____
	T _____ R _____	_____
2. Property Controlling in Section	S _____ T _____ R _____	_____
	S _____ T _____ R _____	_____
3. Miscellaneous Property in Sec.	S _____ T _____ R _____	_____
	S _____ T _____ R _____	_____

10790
Register of Deeds Stamp & File Number

4. Lot No. _____, Recorded Plat _____
5. Private Claims _____

I, Randy Kolehouse, in a field survey on January 7 19 98, do hereby certify that under requirements of P.A. 74 Michigan P.A. of 1970, the corner points mentioned in lines 1 and 2 above were in conformance with regulations and rules therefore as required in the current manual of survey instructions of the United States Department of the interior, Bureau of Land Management or by a decree of a Court of Law and/or that the corner points mentioned in lines 3, 4 and 5 above were in conformance with the rules of the Michigan Board of Land Surveyors or by a Decree of a Court of Law; established, re-established, monumented, re-monumented, recovered, found as expressed below:

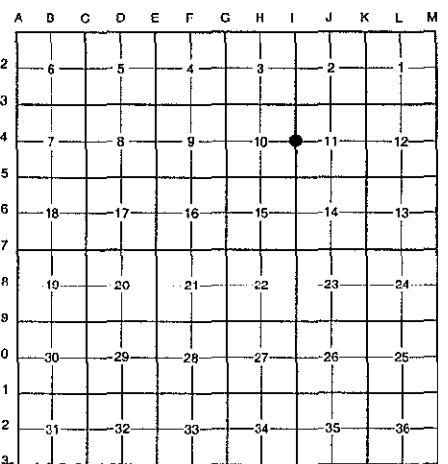

NOTE: Not more than 4 corners, all in the same town and range, may be recorded on this certificate.

A. Description of original monument and accessories and/or subsequent restoration:

1-4	1838	G.L.O. Notes	N. Brookfield	Set Post
	1950	Witness Map	K.C. Surveyor	1/2" Iron
	1975	L.C.R.C. #893	Exxel Engineering	"T" Iron
	1981	L.C.R.C. #1951	Jonker Land Survey	Fnd. 3/4" Iron in Mon. Box / Set K.C. Monument in Mon. Box
	1995	L.C.R.C. #8232	William Byl	K.C. Monument

P.A. 345 1990 KENT COUNTY
PEER APPROVED 12/19/88
CHAIRMAN Randy Kolehouse

This corner was originally approved by the Kent County Remonumentation Peer Group and monumented by Rob Jonker on 8/5/81 and was recorded per L.C.R.C. #1951.

B. Description of corner evidence found and/or method applied in restoring or reestablishing corner:

1-4 Found a Standard Kent County Monument in a monument box on the C/L of Lincoln Lake Road (bit.) running North and South, on line of a tree row running East and West, per L.C.R.C.'s #1951 and #8232 as set by Rob Jonker in place of a 3/4" rd. iron he found in a monument box which checked L.C.R.C. #893 and the K.C. Surveyor's records.

L.C.R.C. #1951

L.C.R.C. #8232

- Remon. tag on N side 30" Oak N86°W 42.76'
- Remon. tag on N side p.pole N59°W 72.80'
- Remon. tag on S side 12" Oak S84°E 50.23'
- Remon. tag on NW side 28" Oak S24°W 107.74'


- Nail & KC Remon. tag N. side 40" Oak N86°W 42.75'
- Nail & KC Remon. tag N. side P. Pole N59°W 72.80'
- Nail & KC Remon. tag S. side 20" Oak S84°E 50.12'
- Nail & KC Remon. tag NW side 36" Oak S24°W 107.62'
- On C/L N-S blacktop

The selected location is accepted by me and is generally accepted by professional surveyors as the best available evidence of the position of the original corner.

C. Description of monument for corner and accessories established to perpetuate locating the position of the corner:

1-4 Standard Kent County Monument in a Monument Box

- Nail & K.C. remon. tag on N side 40" Oak N 86° W 42.75'
- Nail & K.C. remon. tag on N side P. pole N 59° W 72.80'
- Nail & K.C. remon. tag on S side 22" Oak S 84° E 50.12'
- Nail & K.C. remon. tag on NW side 36" Oak S 24° W 107.62'
- Nail & K.C. remon. tag on NW side 4" above grade in 6" Box Elder N 30° E 102.05'
- On C/L bit. road running N-S
- On tree row running E-W

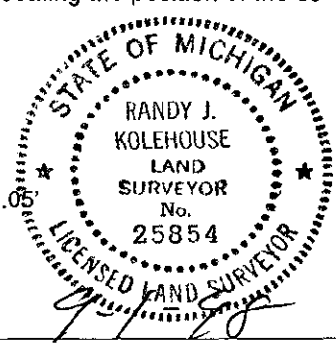

Signed by Randy J. Kolehouse Date _____

EARTH TECH

Surveyor's Michigan License No. 25854