

\$7.00
\$2.00

MAR 08 1999

SECTION

LAND CORNER RECORDATION CERTIFICATE
Filing Requirement of Act 74, Mich. P.A. 1970
KENT COUNTY REMONUMENTATION

For corners in

Kent (County)	Located in: Vergennes Township	Corner Code #
1. Public Land Survey	T <u>7N</u> R <u>9W</u>	<u>I-5</u>
	T _____ R _____	_____
	T _____ R _____	_____
	T _____ R _____	_____
2. Property Controlling in Section	S _____ T _____ R _____	_____
	S _____ T _____ R _____	_____
3. Miscellaneous Property in Sec.	S _____ T _____ R _____	_____
	S _____ T _____ R _____	_____
4. Lot No. _____, Recorded Plat _____		
5. Private Claims _____		

STATE OF MICHIGAN
COUNTY OF KENT
RECEIVED FOR RECORD


38 OCT 23 AM 9:52
107915

REG. OF DEEDS

Register of Deeds Stamp & File Number

I, Randy Kolehouse, in a field survey on January 7 19 98, do hereby certify that under requirements of P.A. 74 Michigan P.A. of 1970, the corner points mentioned in lines 1 and 2 above were in conformance with regulations and rules therefore as required in the current manual of survey instructions of the United States Department of the interior, Bureau of Land Management or by a decree of a Court of Law and/or that the corner points mentioned in lines 3, 4 and 5 above were in conformance with the rules of the Michigan Board of Land Surveyors or by a Decree of a Court of Law; established, re-established, monumented, re-monumented, recovered, found as expressed below:

NOTE: Not more than 4 corners, all in the same town and range, may be recorded on this certificate.

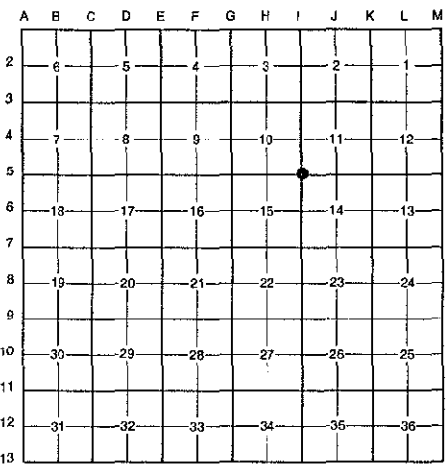

A. Description of original monument and accessories and/or subsequent restoration:

I-5	1838	G.L.O. Notes	N. Brookfield	Set Post
	1950	Witness Map	K.C. Surveyor	3" Pipe
	1975	L.C.R.C. #893	Exxel Engineering	1" Iron in Mon. Box
	1981	L.C.R.C. #1949	Jonker Land Survey	Fnd. 1" Iron in Mon. Box / Set K.C. Mon. in Mon. Box
	1995	L.C.R.C. #8233	William Byl	K.C. Monument

P.A. 345 1990 KENT COUNTY
PEER APPROVED 2/19/98
CHAIRMAN Randy Kolehouse

This corner was originally approved by the Kent County Remonumentation Peer Group and monumented by Rob Jonker on 8/5/81 and was recorded per L.C.R.C. #1949.

B. Description of corner evidence found and/or method applied in restoring or reestablishing corner:

I-5 Found a Standard Kent County Monument in a monument box on the C/L of Lincoln Lake Avenue (bit.) running North and South, on line of a tree row running East, per L.C.R.C.'s #1949 and #8233 as set by Rob Jonker in place of a 1" iron he found in a monument box which checked L.C.R.C. #893 and the K.C. Surveyor's records.

L.C.R.C. #1949

L.C.R.C. #8233

Remon. tag on S side p.pole N84°W 58.24'
Remon. tag on S side 32" Oak S87°E 70.44'
Chiseled "X" on S end dr. culv. S39°W 56.71'
Chiseled "X" on S end dr. culv. N11°E 224.11'
On C/L N-S B.T. & in line tree row - East


Nail & KC Remon. tag S. side P. Pole N84°W 58.35'
Nail & KC Remon. tag S. side 36" Oak S87°E 70.38'
Chiseled "X" S. end drive culv. S39°W 56.71'
Chiseled "X" S. end drive culv. N11°E 224.11'
PK Nail SE side P. Pole S30°W 177.18' (m. 177.21')

The selected location is accepted by me and is generally accepted by professional surveyors as the best available evidence of the position of the original corner.

C. Description of monument for corner and accessories established to perpetuate locating the position of the corner:

I-5 Standard Kent County Monument in a Monument Box

Nail & K.C. remon. tag on S side P. pole N 84° W 58.35'
Nail & K.C. remon. tag on S side 36" Oak S 87° E 70.38'
Nail & K.C. remon. tag on E side P. pole S 30° W 177.21'
Chiseled "X" S end 12" conc. dr. culvert S 39° W 56.71'
Chiseled "X" S end 12" conc. dr. culvert N 11° E 224.11'
On C/L bit. road running N-S
On tree row running E

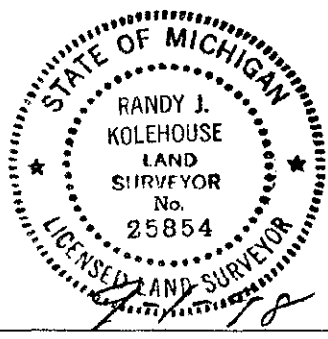

Signed by Randy J. Kolehouse Date _____
EARTH TECH

Surveyor's Michigan License No. 25854