

MAR 08 1999

\$7.00
\$2.00

SECTION

LAND CORNER RECORDATION CERTIFICATE
Filing Requirement of Act 74, Mich. P.A. 1970
KENT COUNTY REMONUMENTATION

For corners in

Kent (County)	Located in: Vergennes Township	Corner Code #
1. Public Land Survey	T <u>7N</u> R <u>9W</u>	<u>I-6</u>
	T _____ R _____	_____
	T _____ R _____	_____
	T _____ R _____	_____
2. Property Controlling in Section	S _____ T _____ R _____	_____
	S _____ T _____ R _____	_____
3. Miscellaneous Property in Sec.	S _____ T _____ R _____	_____
	S _____ T _____ R _____	_____
4. Lot No. _____, Recorded Plat _____		
5. Private Claims _____		

STATE OF MICHIGAN
COUNTY OF KENT
RECEIVED FOR RECORD
98 OCT 23 AM 9:59
REG. OF DEEDS
Eric J. Hahn


10792
Register of Deeds Stamp & File Number

I, Randy Kolehouse, in a field survey on January 7 19 98, do hereby certify that under requirements of P.A. 74 Michigan P.A. of 1970, the corner points mentioned in lines 1 and 2 above were in conformance with regulations and rules therefore as required in the current manual of survey instructions of the United States Department of the interior, Bureau of Land Management or by a decree of a Court of Law and/or that the corner points mentioned in lines 3, 4 and 5 above were in conformance with the rules of the Michigan Board of Land Surveyors or by a Decree of a Court of Law; established, re-established, monumented, re-monumented, recovered, found as expressed below:

NOTE: Not more than 4 corners, all in the same town and range, may be recorded on this certificate.

A. Description of original monument and accessories and/or subsequent restoration:

I-6	1838	G.L.O. Notes	N. Brookfield	Set Post
	1944-67	Witness Map	K.C. Surveyor	Iron and Monument
	1983	L.C.R.C. #3540	T. Chettleburgh	Fnd. Iron Pipe in Mon. Box / Set K.C. Monument
	1995	L.C.R.C. #8234	William Byl	K.C. Monument

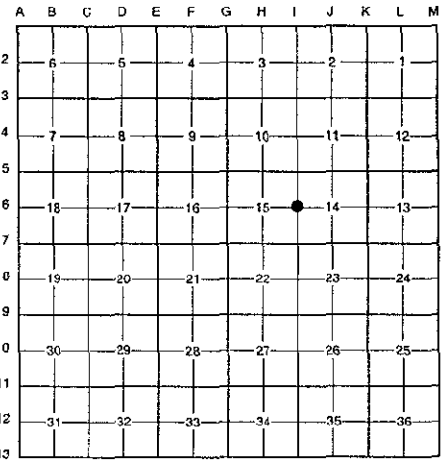

P.A. 345 1990 KENT COUNTY
PEER APPROVED 2/19/99
CHAIRMAN *Harry Chettleburgh*

This corner was originally approved by the Kent County Remonumentation Peer Group and monumented by T. Chettleburgh on 8/9/83 and was recorded per L.C.R.C. #3540.

B. Description of corner evidence found and/or method applied in restoring or reestablishing corner:

I-6 Found a Standard Kent County Monument in a monument box at the C/L intersection of Lincoln Lake Avenue (bit.) running North and South and Downes Street (bit.) running West, on line of a tree row running East, per L.C.R.C.'s #3540 and #8234 as set by T. Chettleburgh in place of an iron pipe he found in a monument box which checked the K.C. Surveyor's records.

L.C.R.C. #3540	L.C.R.C. #8234
Nail in SE side Power Pole SW 112.17'	Nail & KC Remon. tag SE side P. Pole S45°W 112.27' (m. 112.27')
	Nail & KC Remon. tag NE side 12" dbl. Elm N50°W 62.29' (m. 62.29')
	Nail & KC Remon. tag N. side 5" Ash N85°E 48.70'
	Nail & KC Remon. tag SW side 12" Locust S25°E 131.52'
	Nail & KC Remon. tag SE side 12" Pine S50°W 78.97'

The selected location is accepted by me and is generally accepted by professional surveyors as the best available evidence of the position of the original corner.

C. Description of monument for corner and accessories established to perpetuate locating the position of the corner:

I-6 Standard Kent County Monument in a Monument Box
Nail & K.C. remon. tag on SE side P. pole S 45° W 112.27'
Nail & K.C. remon. tag on NE side 12" dbl. Elm N 50° W 62.29'
Nail & K.C. remon. tag on N side 6" Ash N 85° E 48.70'
Nail & K.C. remon. tag on SW side 12" Locust S 24° E 131.52'
Nail & K.C. remon. tag on SE side 12" Pine S 50° W 78.97'
On C/L "X" bit. roads running N-S-W
On line of tree row running E



Signed by *Randy J. Kolehouse* Date _____
EARTH TECH

Surveyor's Michigan License No. 25854