

MAR 08 1999

LAND CORNER RECORDATION CERTIFICATE
Filing Requirement of Act 74, Mich. P.A. 1970
KENT COUNTY REMONUMENTATION

SECTION

For corners in


Kent (County)	Located in: Vergennes Township	Corner Code #
1. Public Land Survey	T <u>7N</u> R <u>9W</u>	<u>1-7</u>
	T _____ R _____	_____
	T _____ R _____	_____
	T _____ R _____	_____
2. Property Controlling in Section	S _____ T _____ R _____	_____
	S _____ T _____ R _____	_____
3. Miscellaneous Property in Sec.	S _____ T _____ R _____	_____
	S _____ T _____ R _____	_____

STATE OF MICHIGAN
COUNTY OF KENT
RECEIVED FOR RECORDS
38 OCT 23 AM 9:58
REG. OF DEEDS
Lucy Bond

10793
Register of Deeds Stamp & File Number

4. Lot No. _____, Recorded Plat _____
5. Private Claims _____

I, Randy Kolehouse, in a field survey on December 29 19 97, do hereby certify that under requirements of P.A. 74 Michigan P.A. of 1970, the corner points mentioned in lines 1 and 2 above were in conformance with regulations and rules therefore as required in the current manual of survey instructions of the United States Department of the interior, Bureau of Land Management or by a decree of a Court of Law and/or that the corner points mentioned in lines 3, 4 and 5 above were in conformance with the rules of the Michigan Board of Land Surveyors or by a Decree of a Court of Law; established, re-established, monumented, re-monumented, recovered, found as expressed below:

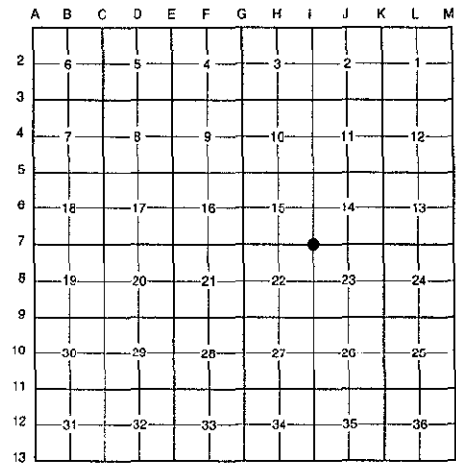

NOTE: Not more than 4 corners, all in the same town and range, may be recorded on this certificate.

A. Description of original monument and accessories and/or subsequent restoration:

I-7	1838	G.L.O. Notes	N. Brookfield	Set Post
	1944	Witness Map	K.C. Surveyor	1" Iron on Leaded Stone
	1973	Witness Map	K.C. Surveyor	Monument Box
	1980	L.C.R.C. #3296	Glaza & Associates	1" Iron in Monument Box
	1983	L.C.R.C. #3455	Williams & Works	Fnd. 3/4" Iron in Mon. Box / Set K.C. Mon. in Mon. Box
	1995	L.C.R.C. #8235	William Byl	K.C. Monument in Mon. Box

P.A. 345 1990 KENT COUNTY
PEER APPROVED 2/19/96
CHAIRMAN Randy Kolehouse

This corner was originally approved by the Kent County Remonumentation Peer Group and monumented by Williams & Works on 7/7/83 and was recorded per L.C.R.C. #3455.

B. Description of corner evidence found and/or method applied in restoring or reestablishing corner:
I-7 Found a Standard Kent County Monument in a monument box .05' East of the C/L intersection of Lincoln Lake Avenue (bit.) running North and South and Mc Pherson Street (bit./gravel) running West, on line of a tree row running East, per L.C.R.C.'s #3455 and #8235 as set by Williams & Works in place of a 3/4" iron they found in a monument box which checked L.C.R.C. #3296 and the K.C. Surveyor's records.

L.C.R.C. #3455

L.C.R.C. #8235


Nail & KC.Remon.tag in NW side P.Pole N.40°E. 78.66'
Nail & KC.Remon.tag in NE side P.Pole N.40°W. 85.50'
Nail & KC.Remon.tag in E'y side P.Pole S.25°W. 95.74'
Nail & KC.Remon.tag in N.side 24" Locust East 42.83'

Nail & KC Remon. tag NW side Power Pole N40°E 78.66' (m. 78.74')
Nail & KC Remon. tag NE side Power Pole N40°W 85.50' (m. 85.55')
Nail & KC Remon. tag E. side Power Pole S25°W 95.74'
Nail & KC Remon. tag N. side 30" Locust East 42.80'

The selected location is accepted by me and is generally accepted by professional surveyors as the best available evidence of the position of the original corner.

C. Description of monument for corner and accessories established to perpetuate locating the position of the corner:
I-7 Standard Kent County Monument in a Monument Box

Nail & K.C. remon. tag on NW side P. pole N 40° E 78.74'
Nail & K.C. remon. tag on NE side P. pole N 40° W 85.55'
Nail & K.C. remon. tag on E side P. pole S 25° W 95.74'
Nail & K.C. remon. tag on N side 30" Locust East 42.80'
C/L "X" of bit. and gravel roads N-S-W, West .05'
On line of tree row running E

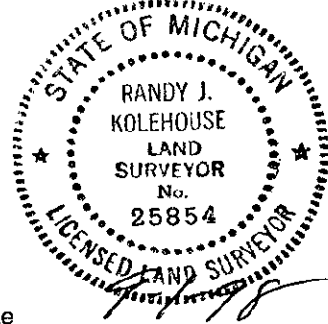

Signed by Randy J. Kolehouse Date _____
EARTH TECH

Surveyor's Michigan License No. 25854