

STATE OF MICHIGAN  
KENT COUNTY SURVEYORS  
REMONUMENTATION

\$7.00  
\$2.00

MAR 08 1999

LAND CORNER RECORDATION CERTIFICATE  
Filing Requirement of Act 74, Mich. P.A. 1970  
KENT COUNTY REMONUMENTATION

STATE OF MICHIGAN  
COUNTY OF KENT  
RECEIVED FOR RECORD  
98 OCT 23 AM 9:58  
REG. OF DEEDS  
*David S. ...*

For corners in

SECTION


Kent (County)	Located in: Vergennes Township	Corner Code #
1. Public Land Survey	T <u>7N</u> R <u>9W</u>	<u>I-9</u>
	T _____ R _____	_____
	T _____ R _____	_____
	T _____ R _____	_____
2. Property Controlling in Section	S _____ T _____ R _____	_____
	S _____ T _____ R _____	_____
3. Miscellaneous Property in Sec.	S _____ T _____ R _____	_____
	S _____ T _____ R _____	_____
4. Lot No. _____, Recorded Plat _____		
5. Private Claims _____		

10795

Register of Deeds Stamp & File Number

I, Randy Kolehouse, in a field survey on January 7 19 98, do hereby certify that under requirements of P.A. 74 Michigan P.A. of 1970, the corner points mentioned in lines 1 and 2 above were in conformance with regulations and rules therefore as required in the current manual of survey instructions of the United States Department of the interior, Bureau of Land Management or by a decree of a Court of Law and/or that the corner points mentioned in lines 3, 4 and 5 above were in conformance with the rules of the Michigan Board of Land Surveyors or by a Decree of a Court of Law; established, re-established, monumented, re-monumented, recovered, found as expressed below:

NOTE: Not more than 4 corners, all in the same town and range, may be recorded on this certificate.

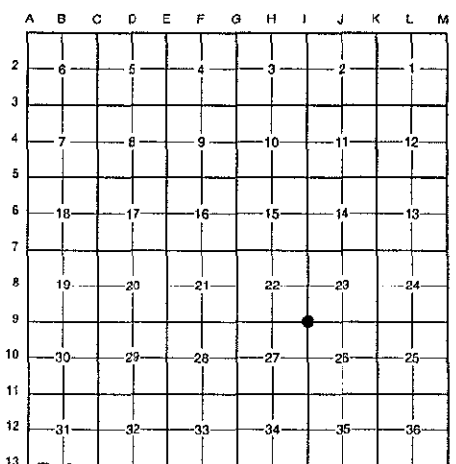

A. Description of original monument and accessories and/or subsequent restoration:

Corner Code	Date	Description	Surveyor	Monument
I-9	1838	G.L.O. Notes	N. Brookfield	Set Post
	1939	Witness Map	K.C. Surveyor	Leaded Stone
	1979	L.C.R.C. #3294	Glaza & Associates	1" Iron
	1984	L.C.R.C. #3829	R. Kolehouse	Fnd. Leaded Stone / Set K.C. Monument
	1995	L.C.R.C. #8237	William Byl	K.C. Monument

P.A. 345 1990 KENT COUNTY

PEER APPROVED 2/19/98

CHAIRMAN Randy Kolehouse

This corner was originally approved by the Kent County Remonumentation Peer Group and monumented by Randy Kolehouse on 4/28/84 and was recorded per L.C.R.C. #3829.

B. Description of corner evidence found and/or method applied in restoring or reestablishing corner:

I-9 Found a Standard Kent County Monument in the woods on line of a large tree row running North and South per L.C.R.C.'s #3829 and #8237 as set by Randy Kolehouse in place of a 10"x14"x24" leaded stone he found with an axle shaft along side which checked L.C.R.C. #3294 and the K.C. Surveyor's records.

L.C.R.C. #3829

L.C.R.C. #8237

- Nail & K.C. Remon. tag in E. side 14" Oak North 25.72'
- Nail & K.C. Remon. tag in SW side 10" Oak N 60 W 21.20'
- Nail & K.C. Remon. tag in N. side 10" Oak S 70 W 18.85'
- Nail & K.C. Remon. tag in W. side 18" Oak S 10 E 15.47'
- Nail & K.C. Remon. tag in N. side 8" Oak S 70 E 19.57'
- Steel fence post West 0.5' Axle shaft South 0.3'
- In tree & fence line running North & South

- Nail & KC Remon. tag E. side 18" Oak N00°E 25.70'
- Nail & KC Remon. tag SW side 12" Oak N60°W 21.21' (m. 21.17')
- Nail & KC Remon. tag N. side 14" Oak S70°W 18.88'
- Nail & KC Remon. tag W. side 22" Oak S10°E 15.41' (m. 15.46')
- Nail & KKC Remon. tag N. side 10" Oak S70°E 19.64'
- Steel fence post West 0.5'; Axle shaft South 0.3'
- In tree and fence line running North & South

The selected location is accepted by me and is generally accepted by professional surveyors as the best available evidence of the position of the original corner.

C. Description of monument for corner and accessories established to perpetuate locating the position of the corner:

- I-9 Standard Kent County Monument
- Nail & K.C. remon. tag on E side 18" Oak N 00° E 25.70'
- Nail & K.C. remon. tag on SW side 12" Oak N 60° W 21.17'
- Nail & K.C. remon. tag on N side 14" Oak S 70° W 18.88'
- Nail & K.C. remon. tag on W side 22" Oak S 10° E 15.46'
- Nail & K.C. remon. tag on N side 10" Oak S 70° E 19.64'
- Axle shaft South 0.3'
- On tree row running N-S

Signed by Randy J. Kolehouse Date \_\_\_\_\_

EARTH TECH

Surveyor's Michigan License No. 25854

