

\$7.00
\$2.00

DEC 14 1998

LAND CORNER RECORDATION CERTIFICATE
Filing Requirement of Act 74, Mich. P.A. 1970
KENT COUNTY REMONUMENTATION

STATE OF MICHIGAN
COUNTY OF KENT
RECEIVED FOR RECORD
98 DEC 14 AM 8:00
REG. OF DEEDS

11026

Register of Deeds Stamp & File Number

For corners in	SECTION	Located in:	Vergennes Township	Corner Code #
Kent (County)				
1. Public Land Survey	T 7N	R 9W		I-10
	T	R		
	T	R		
	T	R		
2. Property Controlling in Section	S	T	R	
	S	T	R	
3. Miscellaneous Property in Sec.	S	T	R	
	S	T	R	

4. Lot No. _____, Recorded Plat _____
5. Private Claims _____


I, Randy Kolehouse, in a field survey on December 1 19 98, do hereby certify that under requirements of P.A. 74 Michigan P.A. of 1970, the corner points mentioned in lines 1 and 2 above were in conformance with regulations and rules therefore as required in the current manual of survey instructions of the United States Department of the Interior, Bureau of Land Management or by a decree of a Court of Law and/or that the corner points mentioned in lines 3, 4 and 5 above were in conformance with the rules of the Michigan Board of Land Surveyors or by a Decree of a Court of Law; established, re-established, monumented, re-monumented, recovered, found as expressed below:

NOTE: Not more than 4 corners, all in the same town and range, may be recorded on this certificate.

A. Description of original monument and accessories and/or subsequent restoration:

I-10	1838	G.L.O. Notes	N. Brookfield	Set Post
	N/A	Witness Map	K.C. Surveyor	Iron
	1982	L.C.R.C. #2822	N/A	1" Iron
	1982	L.C.R.C. #3093	Jonker Land Survey	Fnd. 1/2" Iron / Set K.C. Monument
	1995	L.C.R.C. #8238	William Byl	K.C. Monument
	1996	River Bluff Condo	Roosien Land Surveys	K.C. Monument

P.A. 345 1990 KENT COUNTY
PEER APPROVED 9/24/98
CHAIRMAN Randy Kolehouse

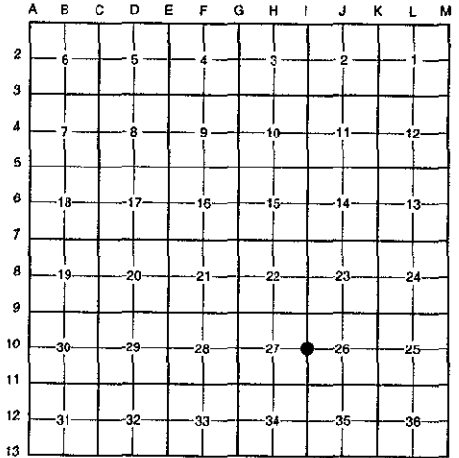

This corner was originally approved by the Kent County Remonumentation Peer Group and monumented by Rob Jonker on 9/14/82 and was recorded per L.C.R.C. #3093.


B. Description of corner evidence found and/or method applied in restoring or reestablishing corner:

I-10 Found a PK nail on the C/L of Burroughs Road (bit.) running East and West, 50' ± West of the West end of bridge, and on line of a tree row running North. Monument and witnesses were gone due to road and bridge construction. Using River Bluff Site Survey, Utility and Easement Plan, determined the found PK to be 0.2' West and 0.08' North. Reset point at true location.

The selected location is accepted by me and is generally accepted by professional surveyors as the best available evidence of the position of the original corner.

C. Description of monument for corner and accessories established to perpetuate locating the position of the corner:

I-10 Replaced PK Nail with a Standard Kent County Monument
Nail & K.C. remon. tag on E side 10" Walnut S 17° W 63.43'
Nail & K.C. remon. tag on E side 10" Walnut N 08° W 43.20'
"X" cut on SW corner conc. structure N 55° E 41.42'
"X" cut on NW corner conc. structure S 83° E 41.35'
On C/L of bit. road running E-W
On tree row running North

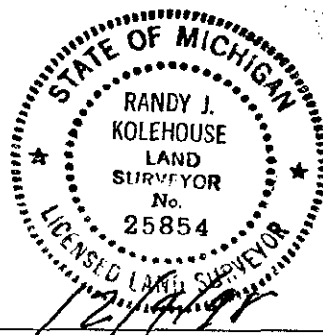

Signed by Randy J. Kolehouse Date 12/14/98
EARTH TECH

Surveyor's Michigan License No. 25854