

\$7.00  
\$2.00

MAR 08 1990

SECTION

LAND CORNER RECORDATION CERTIFICATE  
Filing Requirement of Act 74, Mich. P.A. 1970  
KENT COUNTY REMONUMENTATION

STATE OF MICHIGAN  
COUNTY OF KENT  
RECEIVED FOR RECORDS  
98 OCT 23 AM 9:58  
REG. OF DEEDS  
*Lucy Stand*

10796

Register of Deeds Stamp & File Number

For corners in Kent (County) Located in: Vergennes Township Corner Code #

1. Public Land Survey	T <u>7N</u> R <u>9W</u>	<u>I-11</u>
	T _____ R _____	_____
	T _____ R _____	_____
	T _____ R _____	_____
2. Property Controlling in Section	S _____ T _____ R _____	_____
	S _____ T _____ R _____	_____
3. Miscellaneous Property in Sec.	S _____ T _____ R _____	_____
	S _____ T _____ R _____	_____

4. Lot No. \_\_\_\_\_, Recorded Plat \_\_\_\_\_


5. Private Claims \_\_\_\_\_

I, Randy Kolehouse, in a field survey on December 29 19 97, do hereby certify that under requirements of P.A. 74 Michigan P.A. of 1970, the corner points mentioned in lines 1 and 2 above were in conformance with regulations and rules therefore as required in the current manual of survey instructions of the United States Department of the interior, Bureau of Land Management or by a decree of a Court of Law and/or that the corner points mentioned in lines 3, 4 and 5 above were in conformance with the rules of the Michigan Board of Land Surveyors or by a Decree of a Court of Law; established, re-established, monumented, re-monumented, recovered, found as expressed below:

NOTE: Not more than 4 corners, all in the same town and range, may be recorded on this certificate.

A. Description of original monument and accessories and/or subsequent restoration:

I-11	1838	G.L.O. Notes	N. Brookfield	Set Post
	1941	Witness Map	K.C. Surveyor	1-1/2 Iron
	1971	Witness Map	K.C. Surveyor	3/4" Iron
	1973	L.C.R.C. #505	Williams & Works	1" Iron
	1981	L.C.R.C. #1952	Jonker Land Survey	Fnd. 3/4" Round Iron / Set K.C. Monument
	1995	L.C.R.C. #8239	William Byl	K.C. Monument

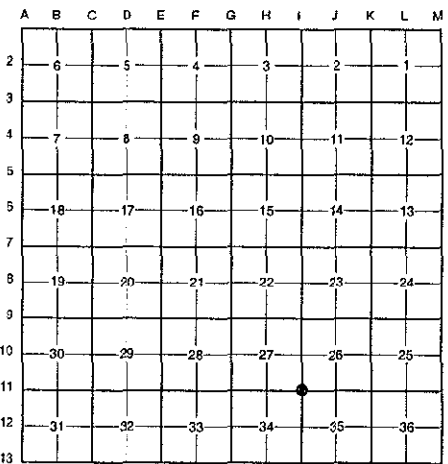

P.A. #345 1990 KENT COUNTY  
PEER APPROVED 2/19/98  
CHAIRMAN Randy Kolehouse

This corner was originally approved by the Kent County Remonumentation Peer Group and monumented by Rob Jonker on 8/4/81 and was recorded per L.C.R.C. #1952.

B. Description of corner evidence found and/or method applied in restoring or reestablishing corner:

I-11	Found a Standard Kent County Monument 2.5' North of the C/L of Vergennes Street (bit.) running East and West per L.C.R.C.'s #1952 and #8239 as set by Rob Jonker in place of a 3/4" round iron he found at grade inside of a 2"x30" pipe 16" below grade which checked L.C.R.C. #505 and the K.C. Surveyor's records.
------	---


L.C.R.C. #1952	L.C.R.C. #8239
Remon. tag on SE side 18" Oak N60°E 50.41'	Nail & KC Remon. tag SE side 24" Oak N60°E 50.43' (m. 50.55')
Remon. tag on E side p.pole N18°E 61.66'	Nail & KC Remon. tag E. side P. Pole N18°E 61.66' (m. 61.68')
Remon. tag on NW side t.pole S43°W 49.85'	Nail & KC Remon. tag SW side 22" Oak N43°W 37.06' (m. 37.03')
Remon. tag on SW side 15" Oak N43°W 37.11'	
NW cor. fnd. To hse. #12864, S14°E 71.40'	

The selected location is accepted by me and is generally accepted by professional surveyors as the best available evidence of the position of the original corner.

C. Description of monument for corner and accessories established to perpetuate locating the position of the corner:

■-11 Standard Kent County Monument

Nail & K.C. remon. tag on SE side 24" Oak N 60° E 50.55'
Nail & K.C. remon. tag on E side P. pole N 18° E 61.68'
Nail & K.C. remon. tag on NW side T. pole S 45° W 49.90'
Nail & K.C. remon. tag on SW side 22" Oak N 43° W 37.03'
NW cor. Hse. Fnd. (#12864) S 14° E 71.50'
C/L bit. road running E-W, South 2.5'

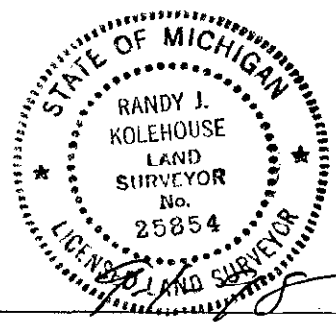

Signed by Randy J. Kolehouse Date \_\_\_\_\_  
EARTH TECH  
Surveyor's Michigan License No. 25854