

KENT COUNTY  
REMONUMENTATION

\$7.00  
\$2.00

MAR 28 1999

**LAND CORNER RECORDATION CERTIFICATE**  
Filing Requirement of Act 74, Mich. P.A. 1970  
KENT COUNTY REMONUMENTATION

SECTION

For corners in

Kent (County)	Located in:	Vergennes Township	Corner Code #
1. Public Land Survey	T <u>7N</u>	R <u>9W</u>	<u>1-12</u>
	T _____	R _____	_____
	T _____	R _____	_____
	T _____	R _____	_____
2. Property Controlling in Section	S _____	T _____	R _____
	S _____	T _____	R _____
3. Miscellaneous Property in Sec.	S _____	T _____	R _____
	S _____	T _____	R _____


STATE OF MICHIGAN  
COUNTY OF KENT  
RECEIVED FOR RECORD  
98 OCT 23 AM 9:58  
REG. OF DEEDS  
*Lucy Stank*

10797

Register of Deeds Stamp & File Number

4. Lot No. \_\_\_\_\_, Recorded Plat \_\_\_\_\_  
5. Private Claims \_\_\_\_\_

I, Randy Kolehouse, in a field survey on January 12 19 98, do hereby certify that under requirements of P.A. 74 Michigan P.A. of 1970, the corner points mentioned in lines 1 and 2 above were in conformance with regulations and rules therefore as required in the current manual of survey instructions of the United States Department of the interior, Bureau of Land Management or by a decree of a Court of Law and/or that the corner points mentioned in lines 3, 4 and 5 above were in conformance with the rules of the Michigan Board of Land Surveyors or by a Decree of a Court of Law; established, re-established, monumented, re-monumented, recovered, found as expressed below:

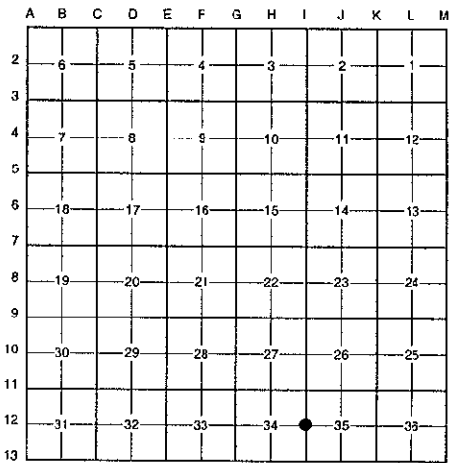

**NOTE: Not more than 4 corners, all in the same town and range, may be recorded on this certificate.**

A. Description of original monument and accessories and/or subsequent restoration:

1-12	Date	Description	Surveyor	Monument
	1838	G.L.O. Notes	N. Brookfield	Set Post
	N/A	Witness Map	K.C. Surveyor	Leaded Stone
	1966	Witness Map	K.C. Surveyor	1-1/2" Iron
	1976	L.C.R.C. #935	Williams & Works	Leaded Stone
	1980	L.C.R.C. #1497	Williams & Works	Fnd. Leaded Stone / Set K.C. Monument
	1995	L.C.R.C. #8240	William Byl	K.C. Monument

P.A. 345 1990 KENT COUNTY

PEER APPROVED 2/19/98

CHAIRMAN *[Signature]*

This corner was originally approved by the Kent County Remonumentation Peer Group and monumented by Williams & Works on 12/5/80 and was recorded per L.C.R.C. #1497.

B. Description of corner evidence found and/or method applied in restoring or reestablishing corner:

1-12 Found a Standard Kent County Monument on line of a tree row running North, South, and East per L.C.R.C.'s #1497 and #8240 as set by Williams & Works in place of a leaded stone they found which checked L.C.R.C. #935 and the K.C. Surveyor's records.

L.C.R.C. #1497

L.C.R.C. #8240

- K.C.R. Tag & Nail in W Side 2" Cedar S 00°E 59.30'
- K.C.R. Tag & Nail in S Side 10" C. Elm N 90°E 166.91'
- K.C.R. Tag & Nail in NW Side 10" Pine N 25°E 84.18'
- K.C.R. Tag & Nail in E Side 10" Triple W. Cherry N 30°W 24.19'
- 1 1/2" Iron Pipe N 90°W 0.46'


- Kent Co. Remon. tag & nail W. side 8" Cedar S00°E 59.30' (m. 59.31')
- Kent Co. Remon. tag & nail S. side 15" C. Elm N90°E 166.97' (m. 166.94')
- Kent Co. Remon. tag & nail NW side 15" Pine N25°E 84.14' (m. 84.11')
- Kent Co. Remon. tag & nail E. side 15" Tri. W.Cherry N10°W 23.99' (m. 23.97')
- Kent Co. Remon. tag & nail SW side 10" Elm S35°E 54.01' (m. 54.05')
- 1 1/2" Iron Pipe N90°W 0.46' (m. 0.45')

The selected location is accepted by me and is generally accepted by professional surveyors as the best available evidence of the position of the original corner.

C. Description of monument for corner and accessories established to perpetuate locating the position of the corner:

1-12 Standard Kent County Monument

- Nail & K.C. remon. tag on W side 8" Cedar S 00° E 59.31'
- Nail & K.C. remon. tag on S side 15" C. Elm N 90° E 166.94'
- Nail & K.C. remon. tag on NW side 15" Pine N 25° E 84.11'
- Nail & K.C. remon. tag on E side 15" Tri. W. Cherry N 10° W 23.97'
- Nail & K.C. remon. tag on SW side 10" Elm S 35° E 54.05'
- 1 1/2" iron pipe N 90° W 0.45'
- On tree row running N-S-E

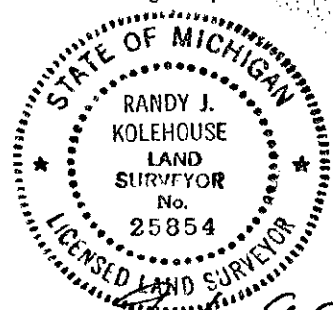

Signed by *Randy J. Kolehouse* Date 2-19-98

EARTHTECH

Surveyor's Michigan License No. 25854