

**SURVEY & REMONUMENTATION**

**KENT COUNTY REMONUMENTATION**

STATE OF MICHIGAN  
COUNTY OF KENT  
RECEIVED FOR RECORD

MAR 03 1998

**LAND CORNER RECORDATION CERTIFICATE**  
Filing Requirement of Act 74, Mich. P.A. 1970

97 APR 29 AM 8:28

For corners in **SECTION**  
**KENT COUNTY**

Located In: Corner Code #

- |                                    |                         |       |
|------------------------------------|-------------------------|-------|
| 1. Public Land Survey              | T <u>7N</u> R <u>9W</u> | I-13  |
|                                    | T _____ R _____         | _____ |
|                                    | T _____ R _____         | _____ |
|                                    | T _____ R _____         | _____ |
| 2. Property Controlling in Section | S _____ T _____ R _____ | _____ |
|                                    | S _____ T _____ R _____ | _____ |
| 3. Miscellaneous Property in Sec.  | S _____ T _____ R _____ | _____ |
|                                    | S _____ T _____ R _____ | _____ |

*Lucy Bond*  
REG. OF DEEDS

9905

Register of Deeds Stamp & File Number

4. Lot No. \_\_\_\_\_, Recorded Plat \_\_\_\_\_  
5. Private Claims \_\_\_\_\_

I, Kirk Breitels, in a field survey on Jan. 14, 1997 do hereby state that under requirements of P.A. 74, Michigan P.A. of 1970, the corner points mentioned in lines 1 and 2 above were in conformance with regulations and rules therefore as required in the current manual of survey instructions of the United States Department of the Interior, Bureau of Land Management or by a decree of a Court of Law and/or that the corner points mentioned in lines 3, 4 and 5 above were in conformance with the rules of the Michigan Board of Land Surveyors or by a Decree of a Court of Law; established, re-established, monumented, recovered, found as expressed below:

NOTE: Not more than 2 corners, all in the same town and range, may be recorded on this certificate.

	A	B	C	D	E	F	G	H	I	J	K	L	M
1													
2	6		5		4		3		2		1		
3													
4	7		8		9		10		11		12		
5													
6	18		17		16		15		14		13		
7													
8	19		20		21		22		23		24		
9													
10	30		29		28		27		26		25		
11													
12	31		32		33		34		35		36		
13													

A. Description of original monument and accessories and/or subsequent restoration:

I-13	GLO	Lyon	Set Post
1879-1983	Williams & Works		Leaded Stone
1968	Kent Co. Wit.		Leaded Stone
1985	LCRC #4200	Rosema	Set Kent County Monument
1995	LCRC #8241	Byl	Kent County Monument

The position of this corner was previously approved by the Kent County Remonumentation Peer Group, monumented by Maurice J. Rosema on 3/7/85 and was recorded per LCRC #4200

B. Description of corner evidence found and/or method applied in restoring or reestablishing corner:


I-13 Found standard Kent Co. Mon. (Harrison) per witnesses from above LCRC as set by Maurice J. Rosema in place of the Leaded Stone he found. Said Leaded Stone checks with Williams & Works information and Kent Co. Wit.

<u>LCRC #4200</u>	<u>LCRC #8241</u>
Nail & tag 30" Mulberry N78°W 17.75'	Nail & tag 40" Mulberry N78°W 17.75'
Nail & tag 8" Mulberry S33°W 75.25'	Nail & tag 18" Mulberry S33°W 75.06'
Nail & tag 24" Maple N17°W 70.15'	Nail & tag 30" Maple N17°W 70.15'
SE cor. siding of house N32°W 84.98'	SE cor. siding of hse. N32°W 84.98'
I-1, T6N, R9W (KC. Mon.) West 54.98'	I-1, T6N, R9W, (KC Mon.) S90°W 54.95'

The selected location is accepted by me and is generally accepted by professional surveyors as the best available evidence of the position of the original corner.

C. Description of monument for corner and accessories established to perpetuate locating the position of the corner:

I-13 Standard Kent County Monument		
Nail & KC Remon. tag N. side 40" Mulberry	N78°W	17.75'
Nail & KC Remon. tag SE side 18" Mulberry	S33°W	75.06'
Nail & KC Remon. tag W. side 30" Maple	N17°W	70.15'
SE cor. wood siding of house	N32°W	84.98'
I-1, T6N, R9W (Kent Co. Mon.)	S90°W	54.95'

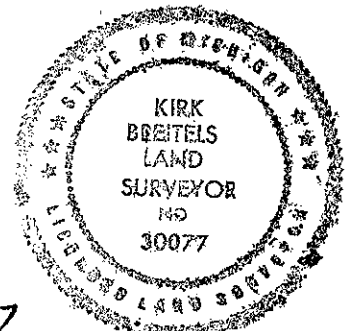

Signed by *Kirk Breitels*  
Surveyor's Michigan License No. 30077

Date 3/27/97

P.A. 345 1990 KENT COUNTY  
PEER APPROVED 3/27/97  
CHAIRMAN *Harry Huber*