

\$7.00
\$2.00

SURVEY & REMONUMENTATION

EST. 1830

LAND CORNER RECORDATION CERTIFICATE

Filing Requirement of Act 74, Mich. P.A. 1970

KENT COUNTY REMONUMENTATION

For corners in

SECTION

Kent
(County)

Located in: Vergennes
Township

Corner Code #

1. Public Land Survey	T <u>7N</u>	R <u>9W</u>	<u>J-2</u>
	T _____	R _____	_____
	T _____	R _____	_____
	T _____	R _____	_____
2. Property Controlling in Section	S _____	T _____	R _____
	S _____	T _____	R _____
3. Miscellaneous Property in Sec.	S _____	T _____	R _____
	S _____	T _____	R _____

STATE OF MICHIGAN
COUNTY OF KENT
RECEIVED FOR RECORD

98 DEC 23 AM 8:52

REG. OF DEEDS
Lucy [Signature]
11065

Register of Deeds Stamp & File Number

4. Lot No. _____, Recorded Plat _____
5. Private Claims _____


I, Randy Kolehouse, in a field survey on December 9 19 98, do hereby certify that under requirements of P.A. 74 Michigan P.A. of 1970, the corner points mentioned in lines 1 and 2 above were in conformance with regulations and rules therefore as required in the current manual of survey instructions of the United States Department of the interior, Bureau of Land Management or by a decree of a Court of Law and/or that the corner points mentioned in lines 3, 4 and 5 above were in conformance with the rules of the Michigan Board of Land Surveyors or by a Decree of a Court of Law; established, re-established, monumented, re-monumented, recovered, found as expressed below:

NOTE: Not more than 4 corners, all in the same town and range, may be recorded on this certificate.

A. Description of original monument and accessories and/or subsequent restoration:

J-2 This corner was not originally set by the G.L.O.

No information on record for this corner.

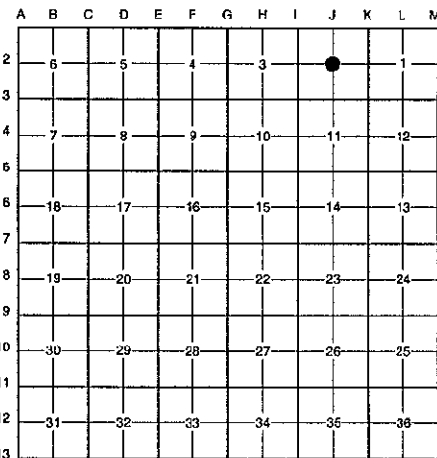

P.A. 345 1990 KENT COUNTY
PEER APPROVED 6/20/98
CHAIRMAN *[Signature]*

B. Description of corner evidence found and/or method applied in restoring or reestablishing corner:

J-2 Set a monument at the intersection of 1/4 lines. Monument is 3' South of a fence line and tree row running East and West and 6' East of a fence line running North.

The selected location is accepted by me and is generally accepted by professional surveyors as the best available evidence of the position of the original corner.

C. Description of monument for corner and accessories established to perpetuate locating the position of the corner:

J-2 Set a Standard Kent County Monument

- Nail & K.C. remon. tag on W side 8" Oak N 02° W 3.62'
- Nail & K.C. remon. tag on SW side 10" Oak N 45° W 23.66'
- Nail & K.C. remon. tag on S side 12" Oak N 89° W 13.65'
- Nail & K.C. remon. tag on S side 12" Oak N 85° E 26.23'
- Fence line and tree row running East and West, North 3' ±
- Fence line running North, West 6' ±



Signed by *Randy J. Kolehouse* Date 12/19/98
EARTH TECH

Surveyor's Michigan License No. 25854