

\$7.00
\$2.00

APR 08 1999

LAND CORNER RECORDATION CERTIFICATE
Filing Requirement of Act 74, Mich. P.A. 1970
KENT COUNTY REMONUMENTATION

For corners in SECTION
Kent
 (County)

Located in: Vergennes Township Corner Code #


- | | | | |
|------------------------------------|-------------|-------------|------------|
| 1. Public Land Survey | T <u>7N</u> | R <u>9W</u> | <u>J-4</u> |
| | T _____ | R _____ | _____ |
| | T _____ | R _____ | _____ |
| | T _____ | R _____ | _____ |
| 2. Property Controlling in Section | S _____ | T _____ | R _____ |
| | S _____ | T _____ | R _____ |
| 3. Miscellaneous Property in Sec. | S _____ | T _____ | R _____ |
| | S _____ | T _____ | R _____ |

4. Lot No. _____, Recorded Plat _____
 5. Private Claims _____

STATE OF MICHIGAN
 COUNTY OF KENT
 RECEIVED FOR RECORD
 98 DEC 14 AM 8:00
 REG. OF DEEDS
Luci Standa

10945
 Register of Deeds Stamp & File Number

I, Randy Kolehouse, in a field survey on January 9 19 98, do hereby certify that under requirements of P.A. 74 Michigan P.A. of 1970, the corner points mentioned in lines 1 and 2 above were in conformance with regulations and rules therefore as required in the current manual of survey instructions of the United States Department of the Interior, Bureau of Land Management or by a decree of a Court of Law and/or that the corner points mentioned in lines 3, 4 and 5 above were in conformance with the rules of the Michigan Board of Land Surveyors or by a Decree of a Court of Law; established, re-established, monumented, re-monumented, recovered, found as expressed below:

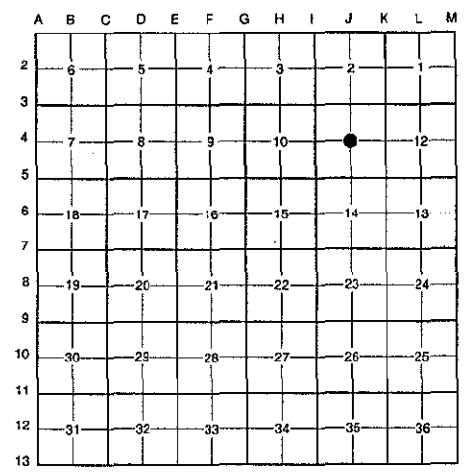

NOTE: Not more than 4 corners, all in the same town and range, may be recorded on this certificate.


- A. Description of original monument and accessories and/or subsequent restoration:
 J-4 This corner was not originally set by the G.L.O.
- | | | | |
|------|--------------------------|-------------------|---|
| N/A | Witness Map | K.C. Surveyor | iron |
| 1966 | Survey Records | Williams & Works | Set Iron at the Intersection of 1/4 Lines |
| 1975 | L.C.R.C. #893 | Exxel Engineering | "T" Iron P.A. 345 1990 KENT COUNTY |
| 1989 | Cert. Survey L. 207 P. 1 | C. Hay | "T" Iron PEER APPROVED 9/24/98 |
| 1989 | L.C.R.C. #5096 | C. Hay | "T" Iron CHAIRMAN <i>Randy Kolehouse</i> |

- B. Description of corner evidence found and/or method applied in restoring or reestablishing corner:
 J-4 Found a "T" iron as set by Williams & Works at the intersection of 1/4 lines in 1966 27.0' ± North of a downed fence line running East and West and 1.5' ± East of a downed fence line running North and South per L.C.R.C.'s #893 and #5096, Cert Survey L. 207 P. 1, and the K.C. Surveyor's records. "T" iron is 0.8' South and 0.1' West of the intersection of 1/4 lines. Accepted iron as Center of Section.

L.C.R.C. #893	L.C.R.C. #5096
Nail in sde 30" Oak SSW 18.31'	Nail & Vcut face 36" Oak N5°W 17.83' (m. 17.68')
Nail in sde 18" Tw. W. Cherry NE 4.78'	Nail side 36" Oak NNW 19.51' (m. 19.52')
Nail in sde 36" Oak NW 19.51'	Nail & V cut, face of 20" W. Ch stump NE 3.90' (m. 3.95')

The selected location is accepted by me and is generally accepted by professional surveyors as the best available evidence of the position of the original corner.

- C. Description of monument for corner and accessories established to perpetuate locating the position of the corner:
 J-4 Replaced "T" Iron with a Standard Kent County Monument
- Scar from V-cut in 36" Oak N 05° E 17.68'
 - Nail & K.C. remon. tag on E side 36" Oak N 05° E 19.52'
 - Nail & K.C. remon. tag on NW side 20" stump N 52° E 3.95'
 - Nail & K.C. remon. tag on S side 30" Oak stump S 18° W 18.51'
 - Nail & K.C. remon. tag on SW side 10" Maple S 65° E 15.08'
 - Nail & K.C. remon. tag on E side 14" Oak due South 23.03'
 - Downed fence line running E-W, South 27.0' ±
 - Downed fence line running N-S, West 1.5' ±

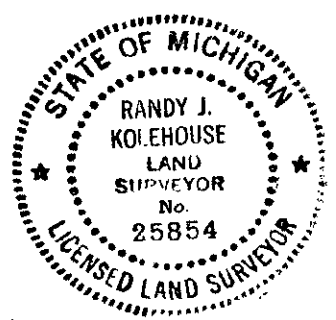

Signed by *Randy J. Kolehouse* Date 11/18/98
 EARTH TECH

Surveyor's Michigan License No. 25854