

\$7.00
\$2.00

DATE 08 1998

SECTION

LAND CORNER RECORDATION CERTIFICATE
Filing Requirement of Act 74, Mich. P.A. 1970
KENT COUNTY REMONUMENTATION

STATE OF MICHIGAN
COUNTY OF KENT
RECEIVED FOR RECORD
98 OCT 23 AM 9:58
REG. OF DEEDS
David S. Board

For corners in


Kent (County)	Located in: Vergennes Township	Corner Code #
1. Public Land Survey	T <u>7N</u> R <u>9W</u>	<u>J-5</u>
	T _____ R _____	_____
	T _____ R _____	_____
	T _____ R _____	_____
2. Property Controlling in Section	S _____ T _____ R _____	_____
	S _____ T _____ R _____	_____
3. Miscellaneous Property in Sec.	S _____ T _____ R _____	_____
	S _____ T _____ R _____	_____

10800

Register of Deeds Stamp & File Number

- 4. Lot No. _____, Recorded Plat _____
- 5. Private Claims _____

I, Randy Kolehouse, in a field survey on January 9 19 98, do hereby certify that under requirements of P.A. 74 Michigan P.A. of 1970, the corner points mentioned in lines 1 and 2 above were in conformance with regulations and rules therefore as required in the current manual of survey instructions of the United States Department of the interior, Bureau of Land Management or by a decree of a Court of Law and/or that the corner points mentioned in lines 3, 4 and 5 above were in conformance with the rules of the Michigan Board of Land Surveyors or by a Decree of a Court of Law; established, re-established, monumented, re-monumented, recovered, found as expressed below:

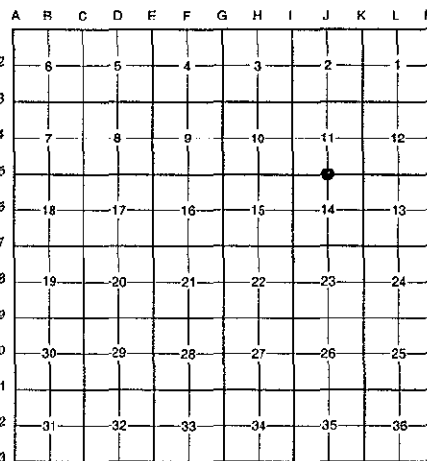

NOTE: Not more than 4 corners, all in the same town and range, may be recorded on this certificate.

A. Description of original monument and accessories and/or subsequent restoration:

J-5	1838	G.L.O. Notes	N. Brookfield	Set Post
	1975	Witness Map	K.C. Surveyor	Stone
	1975	L.C.R.C. #893	Exxel Engineering	Stone
	1980	L.C.R.C. #1734	Williams & Works	Fnd. Stone / Set K.C. Monument
	1995	L.C.R.C. #8243	William Byl	K.C. Monument

P.A. 345 1990 KENT COUNTY
PEER APPROVED 2/19/98
CHAIRMAN Randy Kolehouse

This corner was originally approved by the Kent County Remonumentation Peer Group and monumented by Williams & Works on 12/5/80 and was recorded per L.C.R.C. #1734.

B. Description of corner evidence found and/or method applied in restoring or reestablishing corner:

J-5 Found a Standard Kent County Monument on line of a fence line running East and West per L.C.R.C.'s #1734 and #8243 as set by Williams & Works in place of a stone they found which checked L.C.R.C. #893.

L.C.R.C. #1734

L.C.R.C. #8243

Nail & K.C. Remon. Tag in S Side 12" Oak N 80°E 9.37'
 Nail & K.C. Remon. Tag in E Side 12" Oak N 10°W 18.10'
 Nail & K.C. Remon. Tag in S Side 14" Oak N 70°W 17.52'
 Nail & K.C. Remon. Tag in W Side 22" Oak S 10°E 13.52'
 Nail & K.C. Remon. Tag in NW Side 18" Oak N 25°E 16.76'
 Nail & K.C. Remon. Tag in W Side 8" Maple S 35°E 43.38'


Nail & KC Remon. tag S. side 14" Oak N80°E 9.37'
 Nail & KC Remon. tag E. side 14" Oak N10°W 18.10' (m. 18.09')
 Nail & KC Remon. tag S. side 18" Oak N70°W 17.50' (m. 17.51')
 Nail & KC Remon. tag W. side 26" Oak S10°E 13.52' (m. 13.54')
 Nail & KC Remon. tag NW side 20" Oak N25°E 16.66'
 Nail & KC Remon. tag W. side 8" Maple S35°E 43.52' (m. 43.48')

The selected location is accepted by me and is generally accepted by professional surveyors as the best available evidence of the position of the original corner.

C. Description of monument for corner and accessories established to perpetuate locating the position of the corner:

J-5 Standard Kent County Monument

Nail & K.C. remon. tag on S side 14" Oak N 80° E 9.37'
 Nail & K.C. remon. tag on E side 14" Oak N 10° W 18.09'
 Nail & K.C. remon. tag on S side 18" Oak N 70° W 17.51'
 Nail & K.C. remon. tag on W side 26" Oak S 10° E 13.54'
 Nail & K.C. remon. tag on NW side 20" Oak N 25° E 16.66'
 Nail & K.C. remon. tag on W side 8" Maple S 35° E 43.48'
 On fence line running E-W

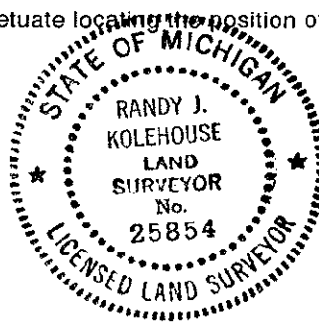

Signed by Randy J. Kolehouse Date 9-1-98

EARTH TECH

Surveyor's Michigan License No. 25854