

\$7.00
\$2.00

DEC 23 1998

LAND CORNER RECORDATION CERTIFICATE
Filing Requirement of Act 74, Mich. P.A. 1970
KENT COUNTY REMONUMENTATION

STATE OF MICHIGAN
COUNTY OF KENT
RECEIVED FOR RECORD
98 DEC 23 AM 8:53

REG. OF NEEDS
Lucy Staveland

11066

Register of Deeds Stamp & File Number

For corners in SECTION _____

Kent (County) Located in: Vergennes Township Corner Code #

1. Public Land Survey T 7N R 9W J-7

2. Property Controlling in Section S _____ T _____ R _____

3. Miscellaneous Property in Sec. S _____ T _____ R _____

4. Lot No. _____, Recorded Plat _____

5. Private Claims _____


I, Randy Kolehouse, in a field survey on January 9 19 98, do hereby certify that under requirements of P.A. 74 Michigan P.A. of 1970, the corner points mentioned in lines 1 and 2 above were in conformance with regulations and rules therefore as required in the current manual of survey instructions of the United States Department of the Interior, Bureau of Land Management or by a decree of a Court of Law and/or that the corner points mentioned in lines 3, 4 and 5 above were in conformance with the rules of the Michigan Board of Land Surveyors or by a Decree of a Court of Law; established, re-established, monumented, re-monumented, recovered, found as expressed below:

NOTE: Not more than 4 corners, all in the same town and range, may be recorded on this certificate.

A. Description of original monument and accessories and/or subsequent restoration:

J-7	1838	G.L.O. Notes	N. Brookfield	Set Post
	1903	Notes	Williams & Works	Cedar Stake
	1939	Witness Map	K.C. Surveyor	1" Iron
	1984	L.C.R.C. #3811	T. Chettleburgh	Fnd. 1" Iron Pipe / Set K.C. Monument
	1995	L.C.R.C. #8244	William Byl	K.C. Monument

P.A. 345 1990 KENT COUNTY
PEER APPROVED 9/24/98
CHAIRMAN Harry Hubel

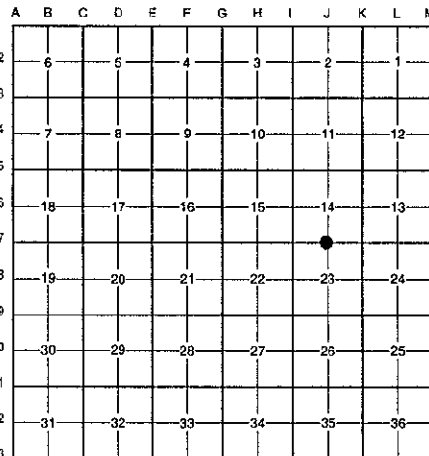

This corner was originally approved by the Kent County Remonumentation Peer Group and monumented by T. Chettleburgh on 2/7/84 and was recorded per L.C.R.C. #3811.

B. Description of corner evidence found and/or method applied in restoring or reestablishing corner:

J-7 Found a Standard Kent County Monument 5' ± East of a tree row and fence line running North, on line of a tree row and fence line running East and West, per L.C.R.C.'s #3811 and #8244 as set by T. Chettleburgh in place of a 1" iron pipe he found which checked the 1903 survey by Williams & Works and K.C. Surveyor's records.

L.C.R.C. #3811

L.C.R.C. #8244

Nail in E side 7" Oak N11E 29.30'	Nail & KC Remon. tag E. side 15" Oak N11°E 29.18' (m. 29.12')
West face 5" dia steel fence cor post N85E 5.01'	W. face of 5" dia. Steel fence cor. post N85°E 5.06'
Center 5" dia steel fence post @ angle point S88E 147.10'	Center 5" dia. Steel fence post @ angle point S88°E 147.10' (m. 147.13')
Nail in S side 16" Oak N78W 12.49'	Nail & KC Remon. tag S. side 24" Oak N78°E 12.47' (m. 12.46')

The selected location is accepted by me and is generally accepted by professional surveyors as the best available evidence of the position of the original corner.

C. Description of monument for corner and accessories established to perpetuate locating the position of the corner:

J-7 Standard Kent County Monument

Nail & K.C. remon. tag on E side 15" Oak N 11° E 29.12'

W face of 5" dia. Steel fence cor. post N 85° E 5.06'


Center of 5" dia. Steel fence post @ angle point S 88° E 147.13'

Nail & K.C. remon. tag on S side 24" Oak N 78° W 12.46'

Nail & K.C. remon. tag on SW side 8" Oak N 45° W 24.48'

Tree row and fence line running N, West 5' ±

On tree row and fence line running E-W

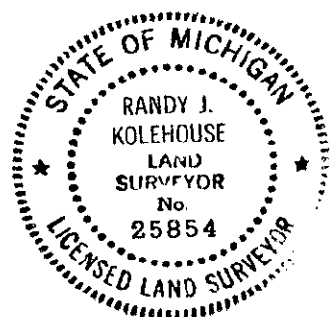

Signed by Randy J. Kolehouse Date 12/14/98
EARTH TECH

Surveyor's Michigan License No. 25854