

1998 10 10 1998

LAND CORNER RECORDATION CERTIFICATE
Filing Requirement of Act 74, Mich. P.A. 1970
KENT COUNTY REMONUMENTATION

For corners in

SECTION


Table with columns: Kent (County), Located in: Vergennes Township, Corner Code #. Rows include Public Land Survey, Property Controlling in Section, Miscellaneous Property in Sec.

STATE OF MICHIGAN
COUNTY OF KENT
RECEIVED FOR RECORD
38 DEC 14 AM 8:00
REG. OF DEEDS

11028

Register of Deeds Stamp & File Number

4. Lot No. , Recorded Plat
5. Private Claims

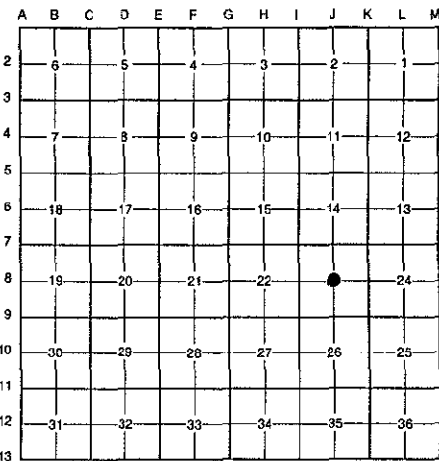

I, Randy Kolehouse, in a field survey on January 15 19 98, do hereby certify that under requirements of P.A. 74 Michigan P.A. of 1970, the corner points mentioned in lines 1 and 2 above were in conformance with regulations and rules therefore as required in the current manual of survey instructions of the United States Department of the Interior, Bureau of Land Management or by a decree of a Court of Law and/or that the corner points mentioned in lines 3, 4 and 5 above were in conformance with the rules of the Michigan Board of Land Surveyors or by a Decree of a Court of Law; established, re-established, monumented, re-monumented, recovered, found as expressed below:

NOTE: Not more than 4 corners, all in the same town and range, may be recorded on this certificate.

A. Description of original monument and accessories and/or subsequent restoration:

Table with columns: J-8, N/A, Witness Map, K.C. Surveyor, Pointed Stone. Rows list survey years (1984, 1989, 1995) and corresponding map numbers and surveyors.

P.A. 345-1990. KENT COUNTY.
PEER APPROVED 12/31/98
CHAIRMAN

B. Description of corner evidence found and/or method applied in restoring or reestablishing corner:

J-8 Found a Standard Kent County Monument on an old fence line and tree row running North and South as set by J. Bueche in place of a pointed stone he found 6.63' South and 2.22' West of the intersection of 1/4 lines which checked L.C.R.C. #4058 and the Kent County Survey's records. Accepted monument as Center of Section.

L.C.R.C. #5232

L.C.R.C. #8245

Nail & Remon. tag in N side 38" Oak N 80° W 10.84'
Nail & Remon. tag in W side 26" Oak N 0° E 3.30'
Nail & Remon. tag in W side 8" W. Ch. S 60° E 16.25'
Nail & Remon. tag in S side 12" Maple N 65° E 17.84'
Nail & Remon. tag in S side 24" Maple S 85° E 42.13'


Nail & KC Remon. tag N. side 42" Oak N80°W 10.84' (m. 10.90')
Nail & KC Remon. tag W. side 30" Oak N00°E 3.35' (m. 3.36')
Nail & KC Remon. tag W. side Tw. 12" W. Cherry S60°E 16.27' (m. 16.29')
Nail & KC Remon. tag S. side 15" Maple N65°E 17.85'
Nail & KC Remon. tag S. side 28" Maple S85°E 42.16' (m. 42.15')

The selected location is accepted by me and is generally accepted by professional surveyors as the best available evidence of the position of the original corner.

C. Description of monument for corner and accessories established to perpetuate locating the position of the corner:

J-8 Standard Kent County Monument

Nail & K.C. remon. tag on N side 30" Oak N 80° W 10.90'
Nail & K.C. remon. tag on W side 24" Oak N 00° E 3.36'
Nail & K.C. remon. tag on W side Twin 12" W. Cherry S 60° E 16.29'
Nail & K.C. remon. tag on S side 15" Maple N 65° E 17.85'
Nail & K.C. remon. tag on S side 28" Maple S 85° E 42.15'
On old fence line and tree row running N-S

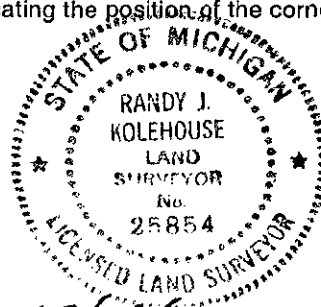

Signed by Randy J. Kolehouse
EARTHTECH

Date 12/4/98

Surveyor's Michigan License No. 25854