

17.00
32.00

DEC 14 1998

LAND CORNER RECORDATION CERTIFICATE
Filing Requirement of Act 74, Mich. P.A. 1970
KENT COUNTY REMONUMENTATION

For corners in

SECTION

Kent (County)	Located in:	Vergennes Township	Corner Code #
1. Public Land Survey	T <u>7N</u>	R <u>9W</u>	J-10
	T _____	R _____	_____
	T _____	R _____	_____
	T _____	R _____	_____
2. Property Controlling in Section	S _____	T _____	R _____
	S _____	T _____	R _____
3. Miscellaneous Property in Sec.	S _____	T _____	R _____
	S _____	T _____	R _____

STATE OF MICHIGAN
COUNTY OF KENT
RECEIVED FOR RECORD

38 DEC 14 AM 8:00

REG. OF DEEDS
Lucy Storch


11032

Register of Deeds Stamp & File Number

4. Lot No. _____, Recorded Plat _____

5. Private Claims _____

I, Randy Kolehouse, in a field survey on January 8 19 98, do hereby certify that under requirements of P.A. 74 Michigan P.A. of 1970, the corner points mentioned in lines 1 and 2 above were in conformance with regulations and rules therefore as required in the current manual of survey instructions of the United States Department of the interior, Bureau of Land Management or by a decree of a Court of Law and/or that the corner points mentioned in lines 3, 4 and 5 above were in conformance with the rules of the Michigan Board of Land Surveyors or by a Decree of a Court of Law; established, re-established, monumented, re-monumented, recovered, found as expressed below:

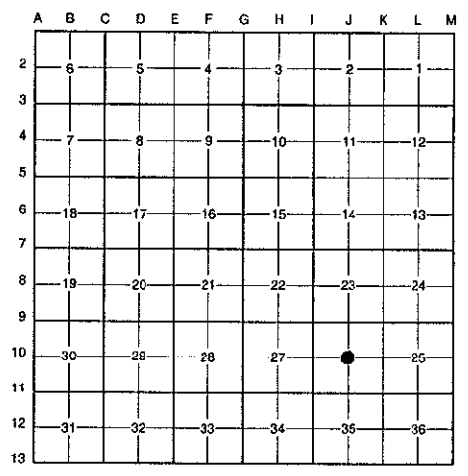

NOTE: Not more than 4 corners, all in the same town and range, may be recorded on this certificate.

- A. Description of original monument and accessories and/or subsequent restoration:
- J-10 This corner was not originally set by the G.L.O.
- | | | | |
|------|----------------|--------------------|----------------------------------|
| 1982 | L.C.R.C. #2822 | Jonker Land Survey | 1" Iron |
| 1989 | L.C.R.C. #5235 | J. Bueche | Fnd. 1" Iron / Set K.C. Monument |
| 1995 | L.C.R.C. #8249 | William Byl | K.C. Monument |

P.A. 345 1990 KENT COUNTY
PEER APPROVED 12/3/98
CHAIRMAN Randy Kolehouse

This corner was originally approved by the Kent County Remonumentation Peer Group and monumented by J. Bueche on 10/2/89 and was recorded per L.C.R.C. #5235.

- B. Description of corner evidence found and/or method applied in restoring or reestablishing corner:
- J-10 Found a Standard Kent County Monument 1.0' South of the C/L of Burroughs Road (gravel) running East and West per L.C.R.C.'s #5235 and #8249 as set by J. Bueche in place of a 1" iron he found 3.55' East of the intersection of 1/4 lines which checked L.C.R.C. #2822. Accepted monument as Center of Section.

L.C.R.C. #5235

L.C.R.C. #8249


- Nail & Remon. tag N side 16" Triple Walnut S 60° W 59.50'
- Nail & Remon. tag S side 14" Elm N 80° W 102.93'
- Nail & Remon. tag E side 8" Elm N 20° W 22.37'
- Nail & Remon. tag W side 12" Oak S 35° E 19.46'
- Nail & Remon. tag N side dbl. 10" Oak S 65° E 57.88'

- Nail & KC Remon. tag N. side 20" Tri. Maple S60°W 59.52'
- Nail & KC Remon. tag S. side 20" Elm N80°W 102.95' (m. 102.98')
- Nail & KC Remon. tag E. side 12" Elm N20°W 22.39' (m. 22.36')
- Nail & KC Remon. tag W. side 16" Oak S35°E 19.45' (m. 19.49')
- Nail & KC Remon. tag N. side dbl. 14" Oak S65°E 57.88' (m. 57.97')

The selected location is accepted by me and is generally accepted by professional surveyors as the best available evidence of the position of the original corner:

- C. Description of monument for corner and accessories established to perpetuate locating the position of the corner:
- J-10 Standard Kent County Monument

- Nail & K.C. remon. tag on N side 20" Tri. Maple S 60° W 59.52'
- Nail & K.C. remon. tag on S side 20" Elm N 80° W 102.98'
- Nail & K.C. remon. tag on E side 12" Elm N 20° W 22.36'
- Nail & K.C. remon. tag on W side 16" Oak S 35° E 19.49'
- Nail & K.C. remon. tag on N side Dbl. 14" Oak S 65° E 57.97'
- C/L gravel road running E-W, North 1.0'

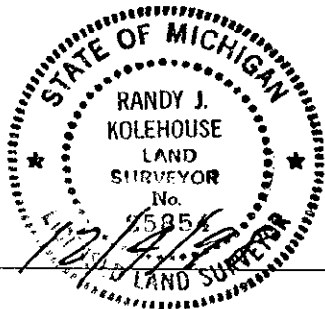

Signed by Randy J. Kolehouse Date 12/3/98

Surveyor's Michigan License No. 25854