

\$7.00
\$2.00

APR 08 1999

LAND CORNER RECORDATION CERTIFICATE
Filing Requirement of Act 74, Mich. P.A. 1970
KENT COUNTY REMONUMENTATION

SECTION

STATE OF MICHIGAN
 COUNTY OF KENT
 RECEIVED FOR RECORD
 38 OCT 23 AM 9:58
 REG. OF DEEDS
Lucy Bond

10801


Register of Deeds Stamp & File Number

For corners in Kent (County) Located in: Vergennes Township Corner Code #

1. Public Land Survey	T <u>7N</u> R <u>9W</u>	<u>J-11</u>
	T _____ R _____	_____
	T _____ R _____	_____
	T _____ R _____	_____
2. Property Controlling in Section	S _____ T _____ R _____	_____
	S _____ T _____ R _____	_____
3. Miscellaneous Property in Sec.	S _____ T _____ R _____	_____
	S _____ T _____ R _____	_____

4. Lot No. _____, Recorded Plat _____

5. Private Claims _____

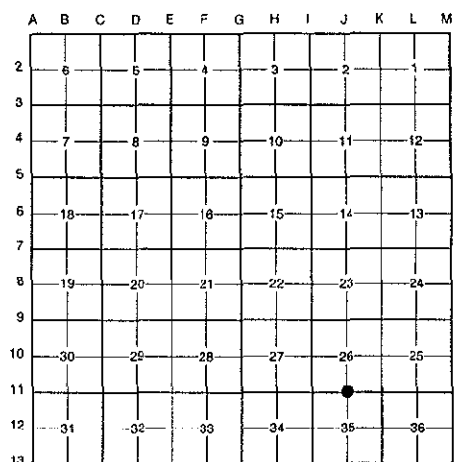

I, Randy Kolehouse, in a field survey on December 29 19 98, do hereby certify that under requirements of P.A. 74 Michigan P.A. of 1970, the corner points mentioned in lines 1 and 2 above were in conformance with regulations and rules therefore as required in the current manual of survey instructions of the United States Department of the interior, Bureau of Land Management or by a decree of a Court of Law and/or that the corner points mentioned in lines 3, 4 and 5 above were in conformance with the rules of the Michigan Board of Land Surveyors or by a Decree of a Court of Law; established, re-established, monumented, re-monumented, recovered, found as expressed below:

NOTE: Not more than 4 corners, all in the same town and range, may be recorded on this certificate.

A. Description of original monument and accessories and/or subsequent restoration:

J-11	1838	G.L.O. Notes	N. Brookfield	Set Post
	1966	Witness Map	K.C. Surveyor	Iron
	1979	L.C.R.C. #1375	Medema, Van Kooten & Assoc.	"T" Iron
	1981	L.C.R.C. #1953	Jonker Land Survey	Fnd. "T" Iron / Set K.C. Monument
	1995	L.C.R.C. #8250	William Byl	K.C. Monument

P.A. 345 1990 KENT COUNTY
 PEER APPROVED 2/19/98
 CHAIRMAN Randy Huber


This corner was originally approved by the Kent County Remonumentation Peer Group and monumented by Rob Jonker on 8/4/81 and was recorded per L.C.R.C. #1953.

B. Description of corner evidence found and/or method applied in restoring or reestablishing corner:
 J-11 Found a Standard Kent County Monument on the C/L of Vergennes Street (bit.) running East and West per L.C.R.C.'s #1953 and #8250 as set by Rob Jonker in place of a "T" iron he found at grade over a 3/4" iron 8" below grade in a pile of stones which checked L.C.R.C. #1375 and the K.C. Surveyor's records.

L.C.R.C. #1953	L.C.R.C. #8250
Remon. tag on W. side p.pole N0°W 59.29'	Nail & KC Remon. tag W. side P. Pole N00°W 59.29' (m. 59.25')
Remon. tag on SE side 16" Oak N35°E 33.13'	Nail & KC Remon. tag SE side 22" Oak N35°E 33.13' (m. 33.05')
Remon. tag on S side 18" Ash S65°E 98.38'	Nail & KC Remon. tag S. side 24" Ash S65°E 98.38' (m. 98.35')
NW cor. garage fnd. S08°E 87.08'	NW cor. garage fnd. S08°E 87.08' (m. 87.10')
Plat monument S01°W m/l 50.02'	Plat monument S01°W 49.99' (m. 50.02')

The selected location is accepted by me and is generally accepted by professional surveyors as the best available evidence of the position of the original corner.

C. Description of monument for corner and accessories established to perpetuate locating the position of the corner:
 J-11 Standard Kent County Monument
 Nail & K.C. remon. tag on W side P. pole N 00° W 59.25'
 Nail & K.C. remon. tag on SE side 22" Oak N 35° E 33.05'
 Nail & K.C. remon. tag on S side 24" Ash S 65° E 98.35'
 Plat mon. S 01° W 50.02'
 NW cor. garage fnd. (hse. #13208) S 08° E 87.10'
 On C/L bit. road running E-W

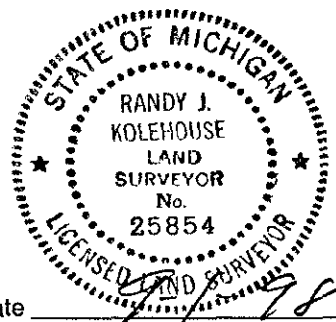

Signed by Randy J. Kolehouse Date 2/19/98
 EARTHTECH
 Surveyor's Michigan License No. 25854