

SURVEY & REMONUMENTATION

MAR 08 1999

LAND CORNER RECORDATION CERTIFICATE
 Filing Requirement of Act 74, Mich. P.A. 1970
 KENT COUNTY REMONUMENTATION

For corners in

<u>Kent</u>	<u>SECTION</u>	Located in:	Vergennes	Corner Code #
(County)		Township		
1. Public Land Survey	T <u>7N</u> R <u>9W</u>			<u>J-12</u>
	T _____ R _____			_____
	T _____ R _____			_____
	T _____ R _____			_____
2. Property Controlling in Section	S _____ T _____	R _____		_____
	S _____ T _____	R _____		_____
3. Miscellaneous Property in Sec.	S _____ T _____	R _____		_____
	S _____ T _____	R _____		_____
4. Lot No. _____, Recorded Plat _____				
5. Private Claims _____				

STATE OF MICHIGAN
 COUNTY OF KENT
 RECEIVED FOR RECORD
 98 DEC 14 AM 8:00
 REG. OF DEEDS
W. J. K. [Signature]

10946

Register of Deeds Stamp & File Number

I, Randy Kolehouse, in a field survey on January 9 19 98, do hereby certify that under requirements of P.A. 74 Michigan P.A. of 1970, the corner points mentioned in lines 1 and 2 above were in conformance with regulations and rules therefore as required in the current manual of survey instructions of the United States Department of the interior, Bureau of Land Management or by a decree of a Court of Law and/or that the corner points mentioned in lines 3, 4 and 5 above were in conformance with the rules of the Michigan Board of Land Surveyors or by a Decree of a Court of Law; established, re-established, monumented, re-monumented, recovered, found as expressed below:

NOTE: Not more than 4 corners, all in the same town and range, may be recorded on this certificate.

A. Description of original monument and accessories and/or subsequent restoration:

J-12 This corner was not originally set by the G.L.O.

1946	Survey Records	Williams & Works	Set Iron at Fence Corner
1970	Survey Records	Williams & Works	Iron 2' N of Fence
1976	L.C.R.C. #935	Williams & Works	Iron
1987	Cert. Survey L. 188 P. 4	Exxel Engineering	Iron

P.A. 345 1990 KENT COUNTY
 PEER APPROVED 9/24/98
 CHAIRMAN [Signature]

B. Description of corner evidence found and/or method applied in restoring or reestablishing corner:

J-12 Found a 1/2" iron pipe 18.0' ± South of the C/L of a drive running East and West on line of a tree row and fence line running East and West per L.C.R.C. #935, Cert. Survey L. 188 P. 4, and the 1946 and 1970 survey records of Williams & Works. Iron pipe is 1.0' South and 2.4' West of the intersection of 1/4 lines. Accepted iron as Center of Section.

Cert. Survey L. 188 P. 4

L.C.R.C. #935

24" Walnut S 75° E 5.60'
 P. Pole East 44.85'
 P. Pole North 33.60'


24" Walnut S 75° E 5.60' (m. 4.75')
 P. Pole E 44.85' (m. 44.87')
 P. Pole N 33.60' (m. 33.63')
 P. Pole N 40°W 75.15' (m. 75.12')

The selected location is accepted by me and is generally accepted by professional surveyors as the best available evidence of the position of the original corner.

C. Description of monument for corner and accessories established to perpetuate locating the position of the corner:

J-12 Replaced Iron Pipe with a Standard Kent County Monument

- Nail & K.C. remon.-tag on W side P. pole N 07° E 33.63'
- Nail & K.C. remon. tag on N side fence post N 90° E 12.67'
- Nail & K.C. remon. tag on S side 8" Elm N 86° W 32.77'
- Nail & K.C. remon. tag on N side P. pole N 87° E 44.87'
- Nail & K.C. remon. tag on NE side P. pole N 40° W 75.12'
- Nail & K.C. remon. tag on N side 26" Walnut S 75° E 4.75'
- On fence line and tree row running E-W
- C/L of gravel drive running E-W, North 18.0'

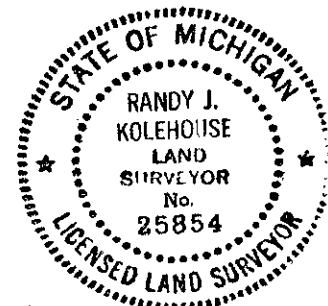

Signed by

[Signature]
 EARTH TECH

Date

11/18/98

Surveyor's Michigan License No.

25854