

\$7.00
\$2.00
FEB 08 1999

STATE OF MICHIGAN
COUNTY OF KENT
RECEIVED FOR RECORD
98 OCT 23 AM 9:58
REG. OF DEEDS
Luigi St. Paul

LAND CORNER RECORDATION CERTIFICATE
Filing Requirement of Act 74, Mich. P.A. 1970
KENT COUNTY REMONUMENTATION

For corners in SECTION _____

Kent (County) Located in: Vergennes Township Corner Code #

1. Public Land Survey T 7N R 9W K-2
T _____ R _____
T _____ R _____
T _____ R _____

2. Property Controlling in Section S _____ T _____ R _____
S _____ T _____ R _____

3. Miscellaneous Property in Sec. S _____ T _____ R _____
S _____ T _____ R _____


4. Lot No. _____, Recorded Plat _____

5. Private Claims _____

10803

Register of Deeds Stamp & File Number

I, Randy Kolehouse, in a field survey on January 7 19 98, do hereby certify that under requirements of P.A. 74 Michigan P.A. of 1970, the corner points mentioned in lines 1 and 2 above were in conformance with regulations and rules therefore as required in the current manual of survey instructions of the United States Department of the interior, Bureau of Land Management or by a decree of a Court of Law and/or that the corner points mentioned in lines 3, 4 and 5 above were in conformance with the rules of the Michigan Board of Land Surveyors or by a Decree of a Court of Law; established, re-established, monumented, re-monumented, recovered, found as expressed below:

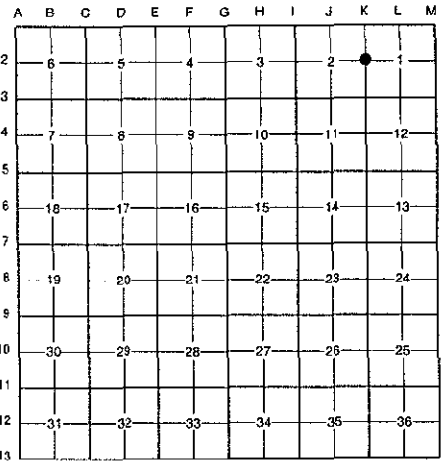

NOTE: Not more than 4 corners, all in the same town and range, may be recorded on this certificate.

A. Description of original monument and accessories and/or subsequent restoration:

K-2	1838	G.L.O. Notes	N. Brookfield	7" Red Oak
	1966	Witness Map	K.C. Surveyor	Iron
	1979	L.C.R.C. #2313	Nederveld & Jonker	1" Round Iron
	1982	L.C.R.C. #3080	Williams & Works	Fnd. 1" Iron / Set K.C. Monument
	1995	L.C.R.C. #8252	William Byl	K.C. Monument

P.A. 345 1990 KENT COUNTY
PEER APPROVED 2/19/98
CHAIRMAN [Signature]

This corner was originally approved by the Kent County Remonumentation Peer Group and monumented by Williams & Works on 7/29/82 and was recorded per L.C.R.C. #3080.

B. Description of corner evidence found and/or method applied in restoring or reestablishing corner:

K-2 Found a Standard Kent County Monument .6' below grade on the C/L of Ashley Road (gravel) running North and South on line of a tree row running East and West per L.C.R.C.'s #3080 and #8252 as set by Williams & Works in place of a 1" iron they found which checked L.C.R.C. #2313 and the K.C. Surveyor's records.

L.C.R.C. #3080

- Nail & KC Remon tag in SE side 12" Wild Cherry S 40°W 54.41'
- Nail & KC Remon tag in N side 48" Sycamore N 80°W 28.77'
- Nail & KC Remon tag in W side 4" Apple N 30°W 59.03'


L.C.R.C. #8252

- Nail & KC Remon. tag SE side 16" W. Cherry S40°W 54.34' (m. 54.31')
- Nail & KC Remon. tag N. side 48" Sycamore N80°W 28.38' (m. 28.37')
- Nail & KC Remon. tag W-side 4" Apple N25°E 56.95' (m. 56.97')
- Nail & KC Remon. tag W. side 8" Apple N30°W 58.85'
- Nail & KC Remon. tag NW side 6" Apple N50°E 47.33' (m. 47.29')

The selected location is accepted by me and is generally accepted by professional surveyors as the best available evidence of the position of the original corner.

C. Description of monument for corner and accessories established to perpetuate locating the position of the corner:

- K-2 Standard Kent County Monument
- Nail & K.C. remon. tag on SE side 16" W. Cherry S 40° W 54.31'
 - Nail & K.C. remon. tag on SE side 48" Sycamore N 80° W 28.37'
 - Nail & K.C. remon. tag on W side 6" Apple N 25° E 56.97'
 - Nail & K.C. remon. tag on W side 8" Apple N 30° W 58.85'
 - Nail & K.C. remon. tag on NW side 6" Apple N 50° E 47.29'
 - On C/L of gravel road running N-S
 - On tree row running E-W

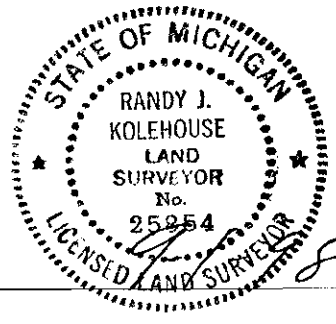

Signed by Randy J. Kolehouse Date _____
EARTH TECH

Surveyor's Michigan License No. 25854