

JAN 08 1999

\$7.00
\$2.00

SECTION

LAND CORNER RECORDATION CERTIFICATE
Filing Requirement of Act 74, Mich. P.A. 1970
KENT COUNTY REMONUMENTATION

REG. OF DEEDS

Randy Kolehouse

38 OCT 23 AM 9:58


STATE OF MICHIGAN
COUNTY OF KENT
RECEIVED FOR RECORD

For corners in

Kent (County)	Located in: Vergennes Township	Corner Code #
1. Public Land Survey	T <u>7N</u> R <u>9W</u>	<u>K-4</u>
	T _____ R _____	_____
	T _____ R _____	_____
	T _____ R _____	_____
2. Property Controlling in Section	S _____ T _____ R _____	_____
	S _____ T _____ R _____	_____
3. Miscellaneous Property in Sec.	S _____ T _____ R _____	_____
	S _____ T _____ R _____	_____
4. Lot No. _____, Recorded Plat _____		
5. Private Claims _____		

10805

Register of Deeds Stamp & File Number

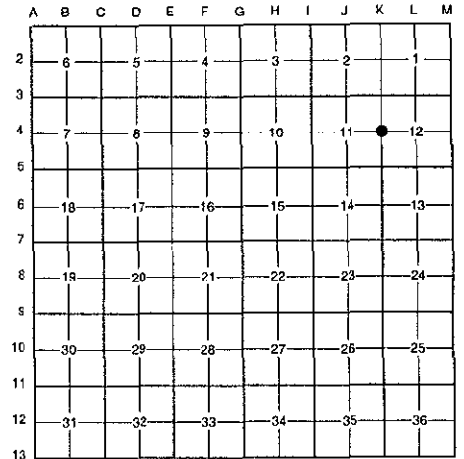

I, Randy Kolehouse, in a field survey on January 13 19 98, do hereby certify that under requirements of P.A. 74 Michigan P.A. of 1970, the corner points mentioned in lines 1 and 2 above were in conformance with regulations and rules therefore as required in the current manual of survey instructions of the United States Department of the interior, Bureau of Land Management or by a decree of a Court of Law and/or that the corner points mentioned in lines 3, 4 and 5 above were in conformance with the rules of the Michigan Board of Land Surveyors or by a Decree of a Court of Law; established, re-established, monumented, re-monumented, recovered, found as expressed below:

NOTE: Not more than 4 corners, all in the same town and range, may be recorded on this certificate.

A. Description of original monument and accessories and/or subsequent restoration:

K-4	1838	G.L.O. Notes	N. Brookfield	Set Post
	1966	Notes	Williams & Works	"T" Iron
	1988	L.C.R.C. #5096	C. Hay	Capped Iron (Moved)
	1990	L.C.R.C. #5575	R. Kolehouse	Reset Temporary Point / Set K.C. Monument
	1995	L.C.R.C. #8254	William Byl	K.C. Monument

P.A. 345 1990 KENT COUNTY
PEER APPROVED 2/19/98

CHAIRMAN Randy Kolehouse

This corner was originally approved by the Kent County Remonumentation Peer Group and monumented by Randy Kolehouse in August 1985 and was recorded per L.C.R.C. 5575.

B. Description of corner evidence found and/or method applied in restoring or reestablishing corner:

K-4 Found a Standard Kent County Monument 330' ± North of a tree row running East and West, on line of a tree and brush row running North and South, per L.C.R.C.'s #5575 and #8254 as reset by Randy Kolehouse midway between Section corners in North and South fence line.

L.C.R.C. #5575

L.C.R.C. #8254

"T" iron West side 16" Wild Cherry Stump South 67.5'
Nail in E. side 12" Walnut North 13.27'
Nail in N. side tri 21" Oak S 05° W 0.77'


"T" Iron W. side 16" W. Cherry Stump S00°W 67.5' (m. 67.52')
Nail E. side 12" Walnut stump N00°W 13.27' (m. 13.28')
Nail N. side Tri. 21" Oak stump S05°W 0.77' (m. 0.76')

The selected location is accepted by me and is generally accepted by professional surveyors as the best available evidence of the position of the original corner.

C. Description of monument for corner and accessories established to perpetuate locating the position of the corner:

K-4 Standard Kent County Monument

- Nail & K.C. remon. tag on W side 16" Cherry stump S 00° W 67.52'
- Nail & K.C. remon. tag on E side 12" Walnut stump N 00° W 13.28'
- Nail & K.C. remon. tag on N side triple 21" Oak stump S 05° W .76'
- Nail & K.C. remon. tag on W side 4" Cherry N 05° W 6.87'
- Tree row running E-W, South 330'
- On tree and brush row running N-S

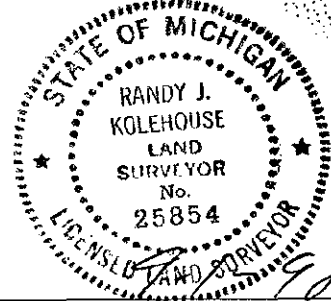

Signed by *Randy J. Kolehouse* Date _____
EARTH TECH

Surveyor's Michigan License No. 25854