

MAR 08 1989

\$7.00
\$2.00

SECTION

LAND CORNER RECORDATION CERTIFICATE
Filing Requirement of Act 74, Mich. P.A. 1970
KENT COUNTY REMONUMENTATION

STATE OF MICHIGAN
COUNTY OF KENT
RECEIVED FOR RECORD
38 OCT 23 AM 9:58
REG. OF DEEDS
Lucy Standa

10808

Register of Deeds Stamp & File Number

For corners in

| Kent (County) | Located in: Vergennes Township | Corner Code # |
|---------------------------------------|-----------------------------------|---------------|
| 1. Public Land Survey | T <u>7N</u> R <u>9W</u> | <u>K-7</u> |
| | T _____ R _____ | _____ |
| | T _____ R _____ | _____ |
| | T _____ R _____ | _____ |
| 2. Property Controlling in Section | S _____ T _____ R _____ | _____ |
| | S _____ T _____ R _____ | _____ |
| 3. Miscellaneous Property In Sec. | S _____ T _____ R _____ | _____ |
| | S _____ T _____ R _____ | _____ |


4. Lot No. _____, Recorded Plat _____
5. Private Claims _____

I, Randy Kolehouse, in a field survey on January 13 19 98, do hereby certify that under requirements of P.A. 74 Michigan P.A. of 1970, the corner points mentioned in lines 1 and 2 above were in conformance with regulations and rules therefore as required in the current manual of survey instructions of the United States Department of the interior, Bureau of Land Management or by a decree of a Court of Law and/or that the corner points mentioned in lines 3, 4 and 5 above were in conformance with the rules of the Michigan Board of Land Surveyors or by a Decree of a Court of Law; established, re-established, monumented, re-monumented, recovered, found as expressed below:

NOTE: Not more than 4 corners, all in the same town and range, may be recorded on this certificate.

A. Description of original monument and accessories and/or subsequent restoration:

| K-7 | 1838 | G.L.O. Notes | N. Brookfield | Set Post |
|-----|------|----------------|-----------------|---|
| | 1984 | L.C.R.C. #3812 | T. Chettleburgh | Fnd. 1-1/4" Iron Pipe / Set K.C. Monument |
| | 1995 | L.C.R.C. #8257 | William Byl | K.C. Monument |

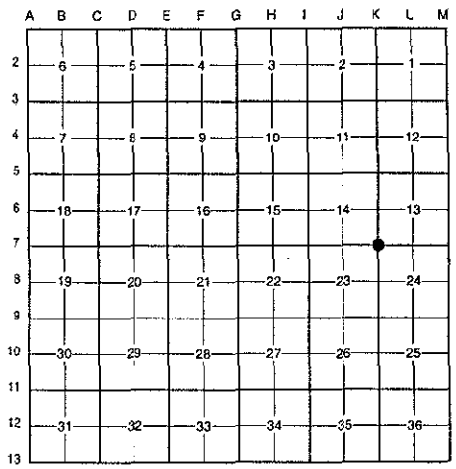

P.A. 345
1990 KENT COUNTY
PEER APPROVED 9/1/98
CHAIRMAN Randy Kolehouse

This corner was originally approved by the Kent County Remonumentation Peer Group and monumented by T. Chettleburgh on 2/20/84 and was recorded per L.C.R.C. #3812.

B. Description of corner evidence found and/or method applied in restoring or reestablishing corner:

K-7 Found a Standard Kent County Monument 250' ± North of the C/L of Mc Pherson Street (bit.) running East and West, 80' ± South of the left bank of the Flat River, and 65' ± East of the left bank of the Flat River per L.C.R.C.'s #3812 and #8257 as set by T. Chettleburgh in place of a 1-1/4" iron pipe he found with a steel fence post guard.

L.C.R.C. #3812

L.C.R.C. #8257


Nail in W side 17" Oak N8E 73.78'
Nail in NW side 6" Oak N47E 63.05'
Nail in N side 24" Cottonwood S78E 102.50'
Nail in S side Multi-18" Cottonwood S75E 67.43'

Nail & KC Remon. tag W. side 17" Oak N08°E 73.86' (m. 73.90')
Nail & KC Remon. tag NW side 6" Oak N 47°E 63.14' (m. 63.20')
Nail & KC Remon. tag W. side Multi-10" Cottonwood S05°W 49.73' (m. 49.74')
Nail & KC Remon. tag SE side 10" Cottonwood S70°W 32.38' (m. 32.32')

The selected location is accepted by me and is generally accepted by professional surveyors as the best available evidence of the position of the original corner.

C. Description of monument for corner and accessories established to perpetuate locating the position of the corner:

K-7 Standard Kent County Monument
Nail & K.C. remon. tag on W side 18" Oak N 08° E 73.90'
Nail & K.C. remon. tag on NW side 12" Oak N 47° E 63.20'
Nail & K.C. remon. tag on W side multi 10" Cottonwoods S 05° W 49.74'
Nail & K.C. remon. tag on SE side 10" Cottonwood S 70° W 32.32'
Nail & K.C. remon. tag on N side 24" Cottonwood S 78° E 102.55'
Nail & K.C. remon. tag on S side multi 18" Cottonwoods S 75° E 67.46'
Left bank of Flat River is N 80' m/l
Left bank of Flat River is W 65' m/l
C/L bit. Road running E-W, South 250'

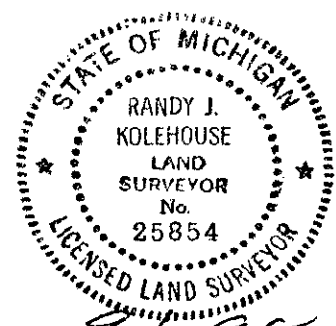

Signed by Randy J. Kolehouse Date 9-1-98
EARTH TECH
Surveyor's Michigan License No. 25854